
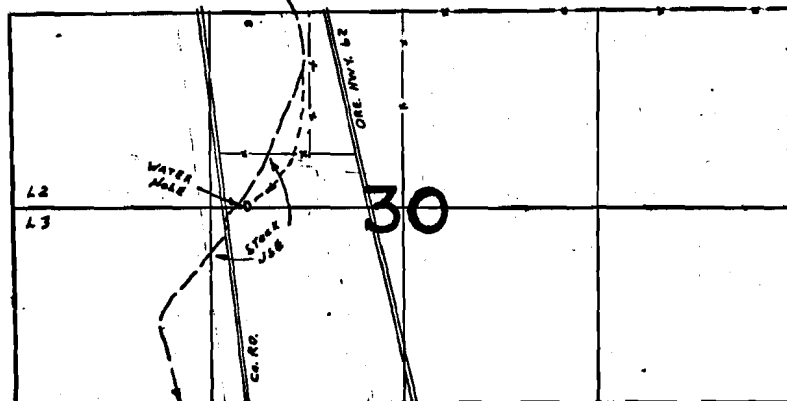


# T.34S. R.7E. W.M.

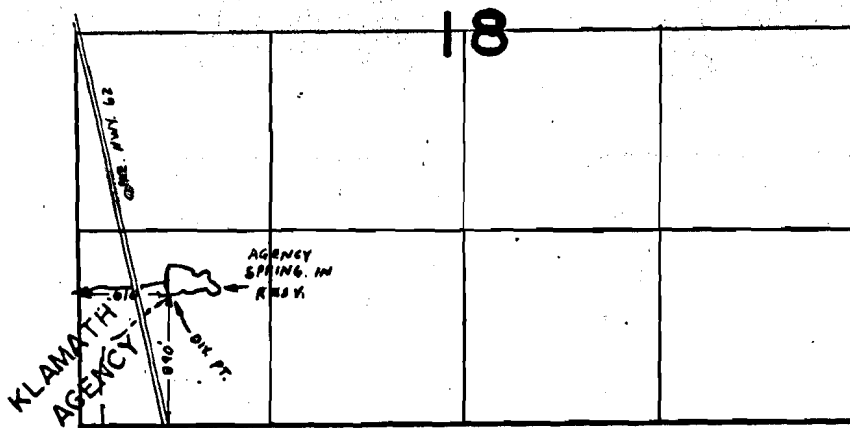


## FINAL PROOF SURVEY UNDER

Application No. 47123 Permit No. 34961  
IN NAME OF

*Charles & Harlene Kimbol*

Surveyed OCT. 17 1974, by LH NUNN