


# T. 18S. R. 2 & 3 W.W.M.

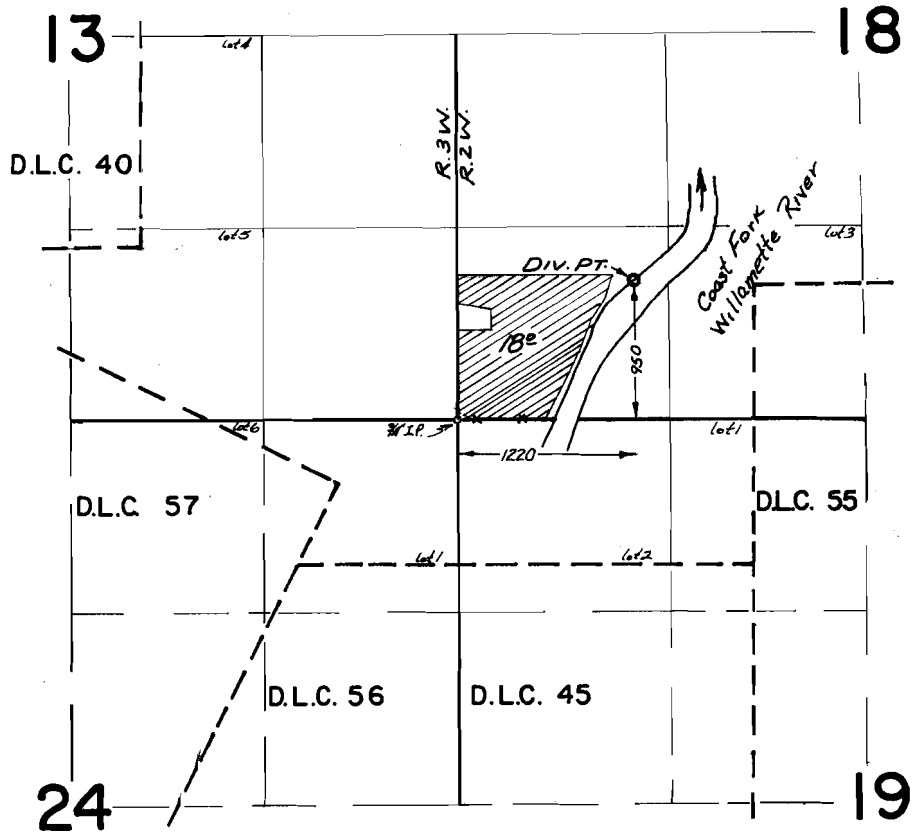

## FINAL PROOF SURVEY UNDER

Application No. 44648 Permit No. 33400  
IN NAME OF

Gordon W. Tripp, Trustee

Surveyed 13 OCT, 1970, by G. BACA  
8 MAY, 1974 R. MUCKEN