copy from file 46841

T.19S. R.47E. W.M.

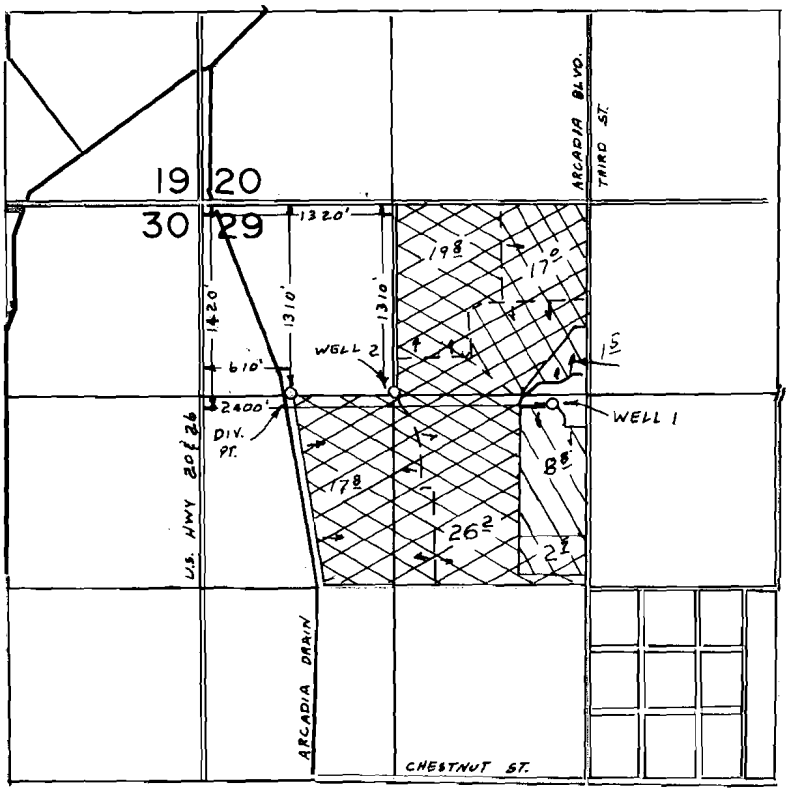

FINAL PROOF SURVEY

UNDER

Application No. ~~G-5142~~ 46841 Permit No. ~~G-4875~~ 35131

IN NAME OF

OWEN G. FROERER

Surveyed JUN 20 1974, by L H NUNN

BBC-IN-94 LHN