


# T.20S. R.47E. W.M.

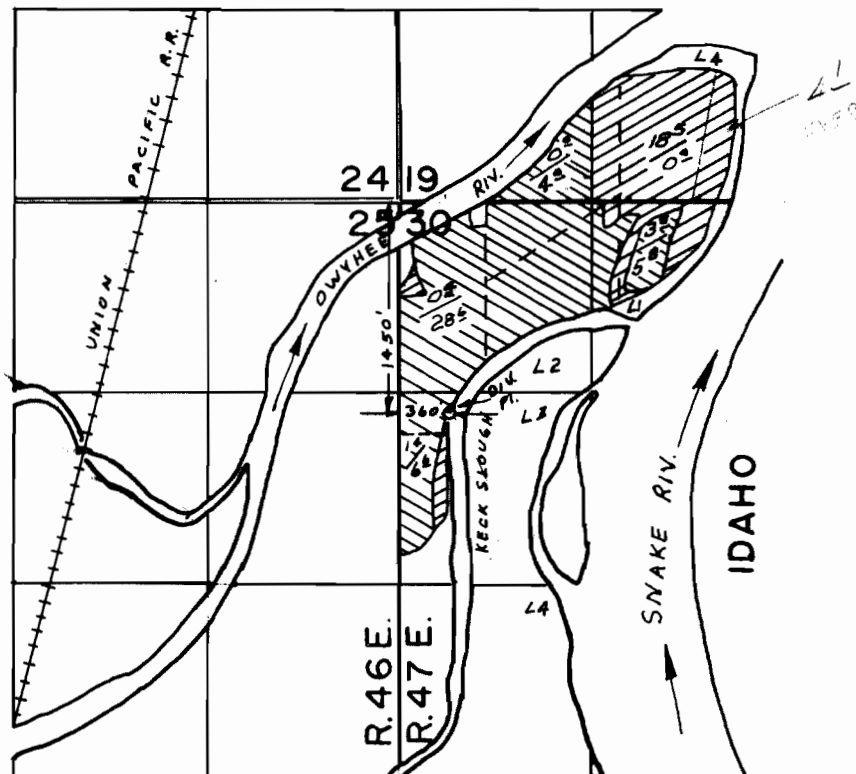

NOTE: ACREAGE SHOWN — PRIMARY / SUPPLEMENTAL  
 LAND SHOWN — PRIMARY / SUPPLEMENTAL

## FINAL PROOF SURVEY UNDER

Application No. 42603 Permit No. 31828  
 IN NAME OF  
 KECK,  
 DENNIS CLIFFORD & MARGARET

Surveyed JUN. 21. 1974, by L.H. NUNN.....