


# T.20S. R.47E. W.M.

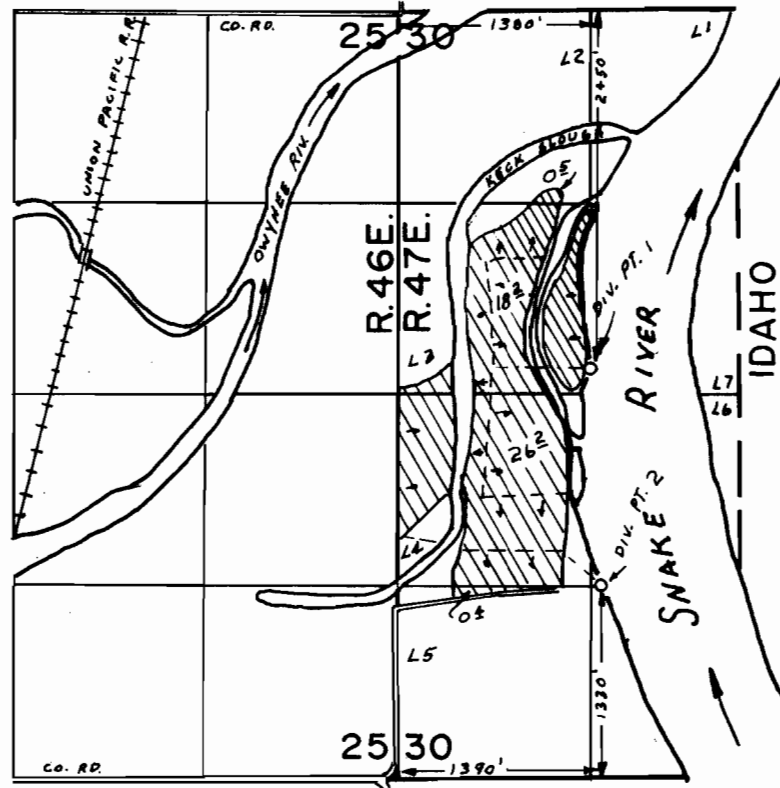

## FINAL PROOF SURVEY UNDER

Application No. 43287 Permit No. 32352  
IN NAME OF

EARL R. KYGAR

Surveyed JUN. 21 1974, by L.H. NUNN