


T.20S. R.46E. W.M.

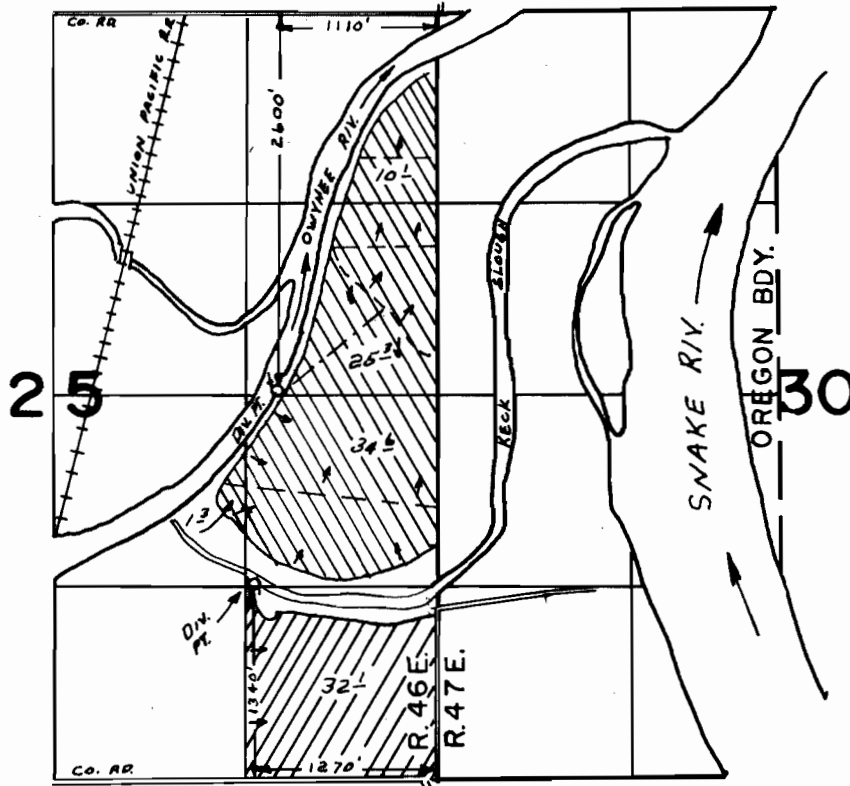

FINAL PROOF SURVEY UNDER

Application No. 44347 Permit No. 33112
IN NAME OF

G. W. STRINGER

Surveyed JUN 21 1974, by LH NUNN