


# T.21S. R.46E. W.M.

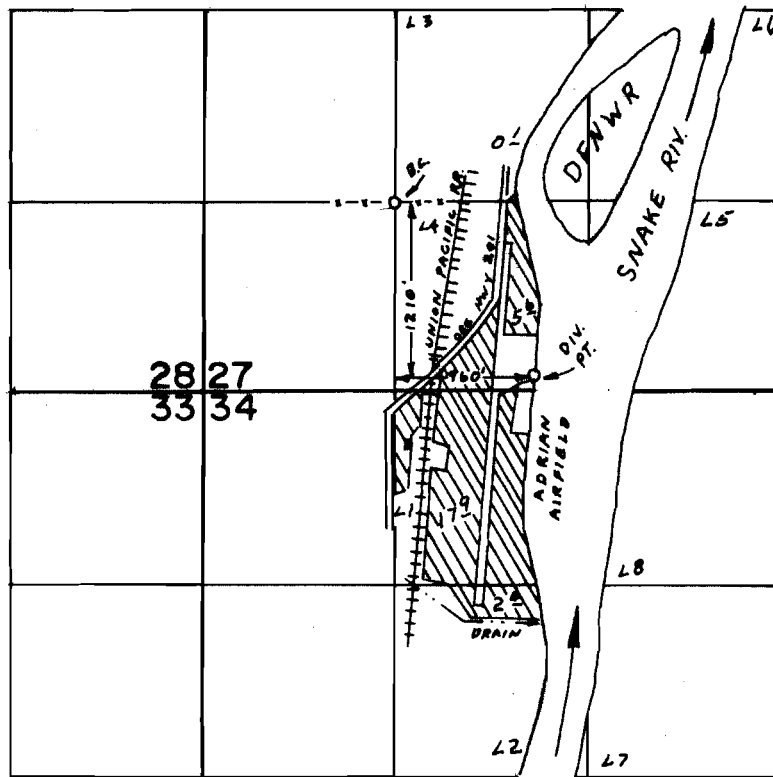

## FINAL PROOF SURVEY UNDER

Application No. 46381 Permit No. 34641  
IN NAME OF

RON ZERBEL

Surveyed JUN 25 1974, by L H NUNN