


T.19S. R.47E. W.M.

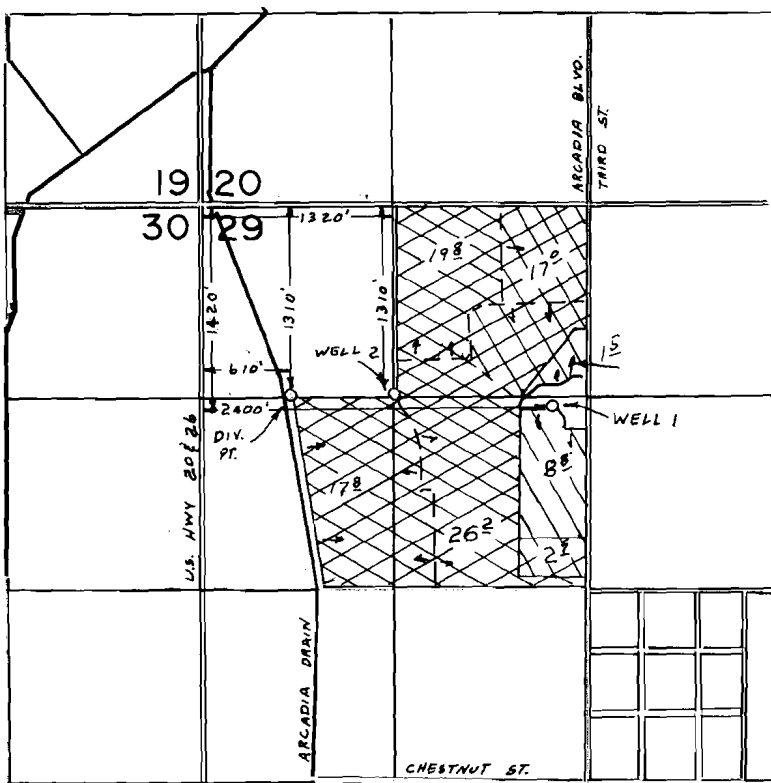

WELL 1 \ \ \

LAND IRRIGATED FROM: WELL 2 \ \ \

ARCADIA DRAIN \ \ \

FINAL PROOF SURVEY UNDER

G-5142

G-4875

Application No. 46841 Permit No. 35131

IN NAME OF

OWEN G. FROERER

Surveyed JUN 20 1974, by L.H. NUNN