


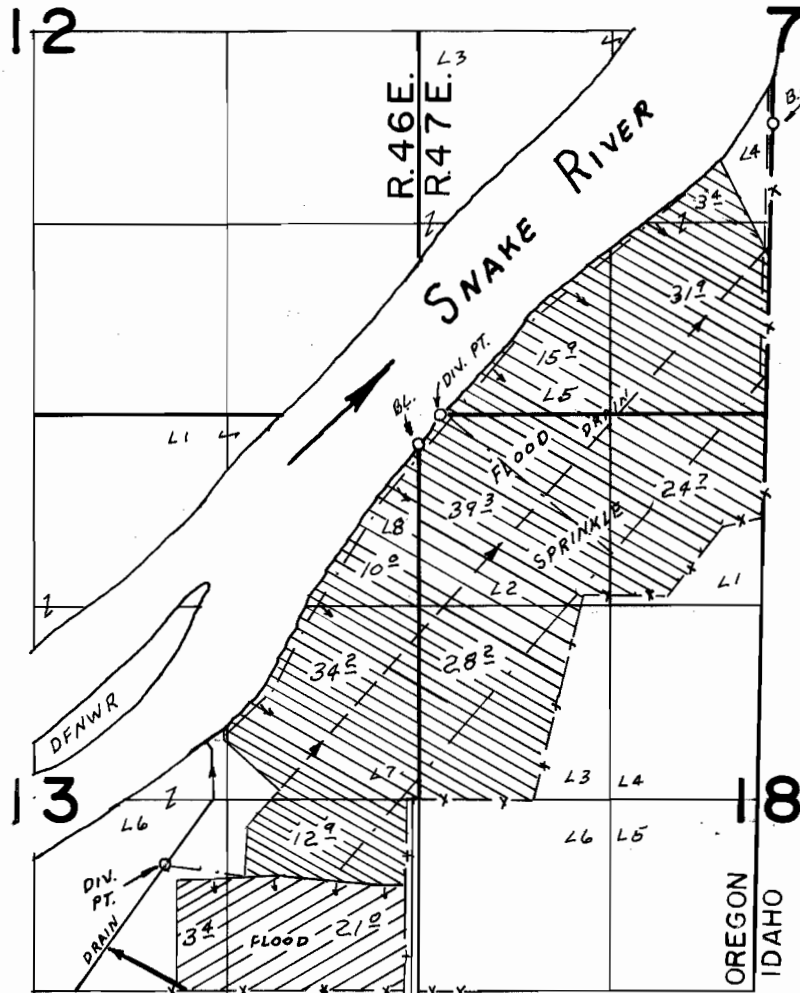

T.21S. R.46 & 47E. W.M.



APP. NO. 49729, PERMIT 37242  FOR LAND
 DIV. PT. LOC. 200' N & 140' E FROM M.C. BET. SECS. 13 & 18
 APP. NO. 49728, PERMIT 37241  FOR LAND
 DIV. PT. LOC. 2870' S & 1740' W FROM M.C. BET. SECS. 13 & 18

FINAL PROOF SURVEY UNDER

Application No. 49729 Permit No. 37242
 IN NAME OF

STEVENS FARMS, INC.

Surveyed JUN. 25 1974, by L.H. MUNN