


# T.21S. R. 46 E. & 47 E. W.M.

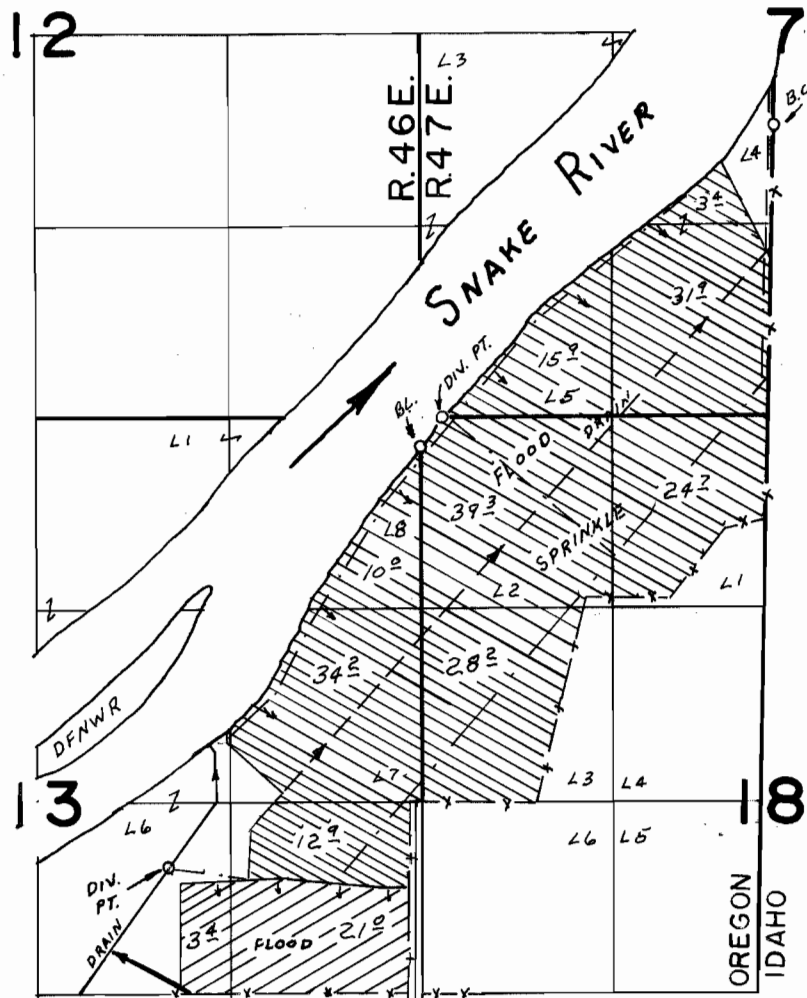

APP. NO. 49729, PERMIT 37242 FOR LAND  
 DIV. PT. LOC. 200' N & 140' E FROM M.C. BET. SECS. 13 & 18  
 APP. NO. 49728, PERMIT 37241 FOR LAND  
 DIV. PT. LOC. 2870' S & 1740' W FROM M.C. BET. SECS. 13 & 18

## FINAL PROOF SURVEY UNDER

Application No. 49729 Permit No. 37242  
 IN NAME OF

STEVENS FARMS, INC.

Surveyed JUN 25 1974, by L.H. NUNN