


T.18S. R.46E. W.M.

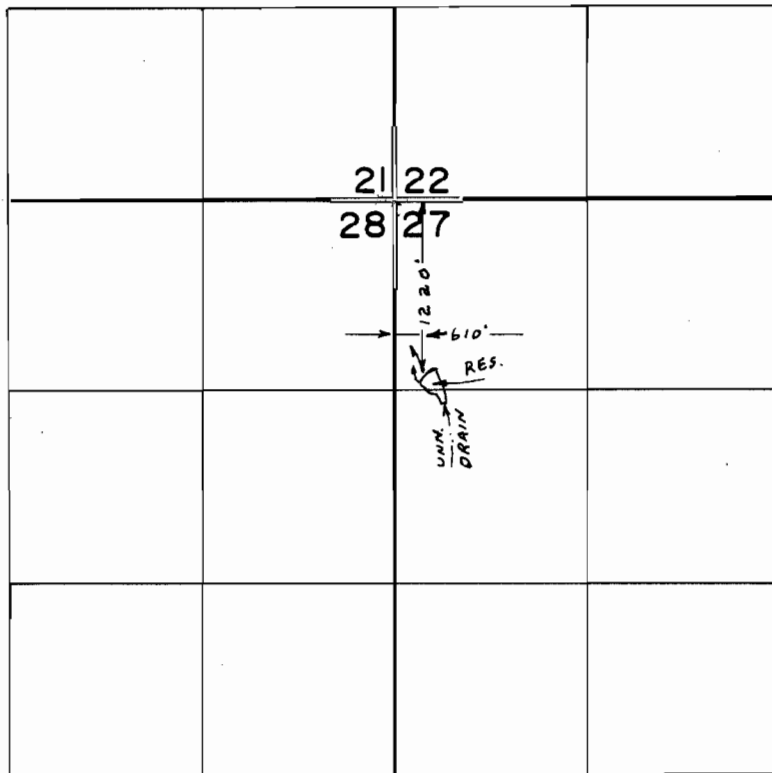

FINAL PROOF SURVEY UNDER

Application No. R-51296 Permit No. R-6047
IN NAME OF

MARLOW L. POUNDS

Surveyed JUN 19 1974, by L.H. NUNN