


T.7S. R.1E. W.M.

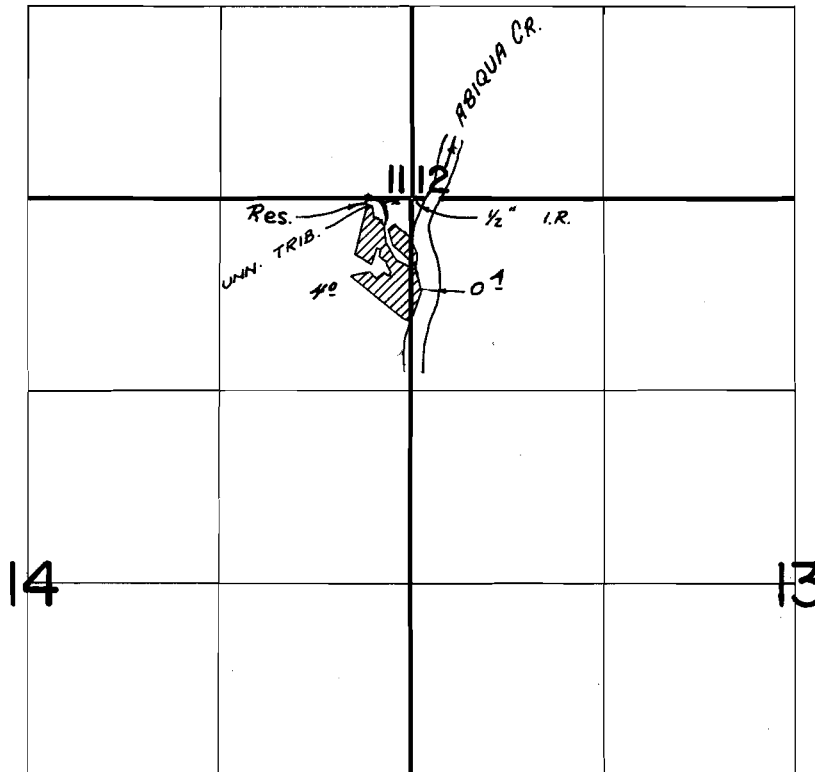

Res. Loc. 50' ± 190' E From NE Cor. Sec. 14

FINAL PROOF SURVEY UNDER

Application No. R-40583 40584 Permit No. R-4552 30272
IN NAME OF

ELBERT MANOR

Surveyed July 5 1973, by R.G. Mucken