


T.8S.R. 2W. W.M.

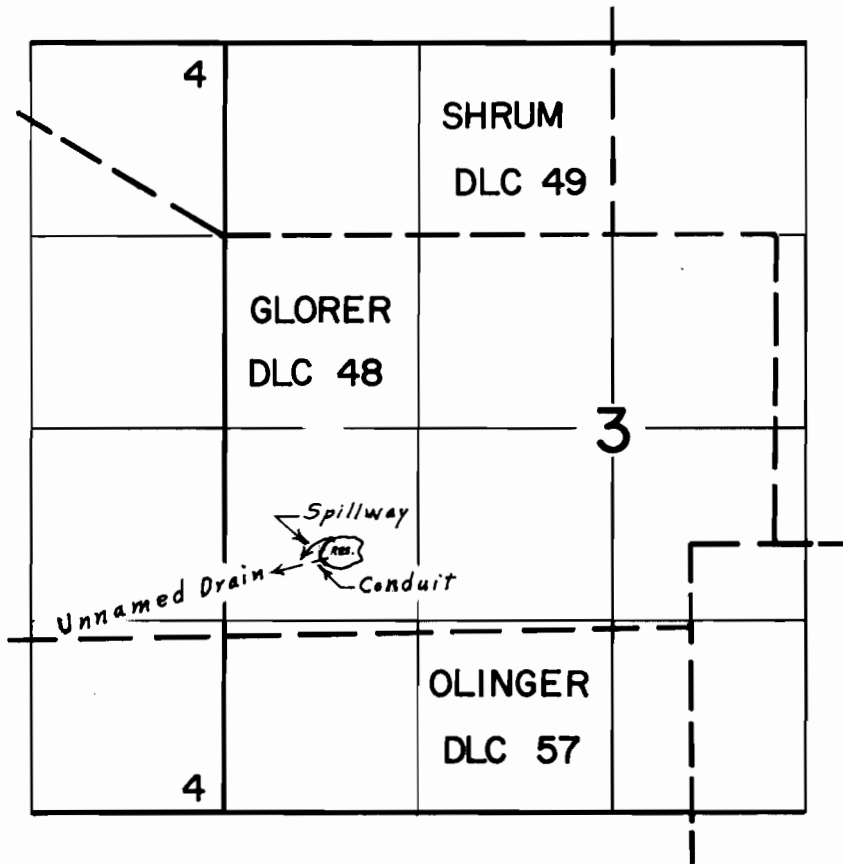

FINAL PROOF SURVEY UNDER

Application No. R-45305 Permit No. R-5347
IN NAME OF

WILLIS W. SHIPMAN

Surveyed AUG-14 1973, by L.E. GOULD