T.9S.R.2E.W.M.

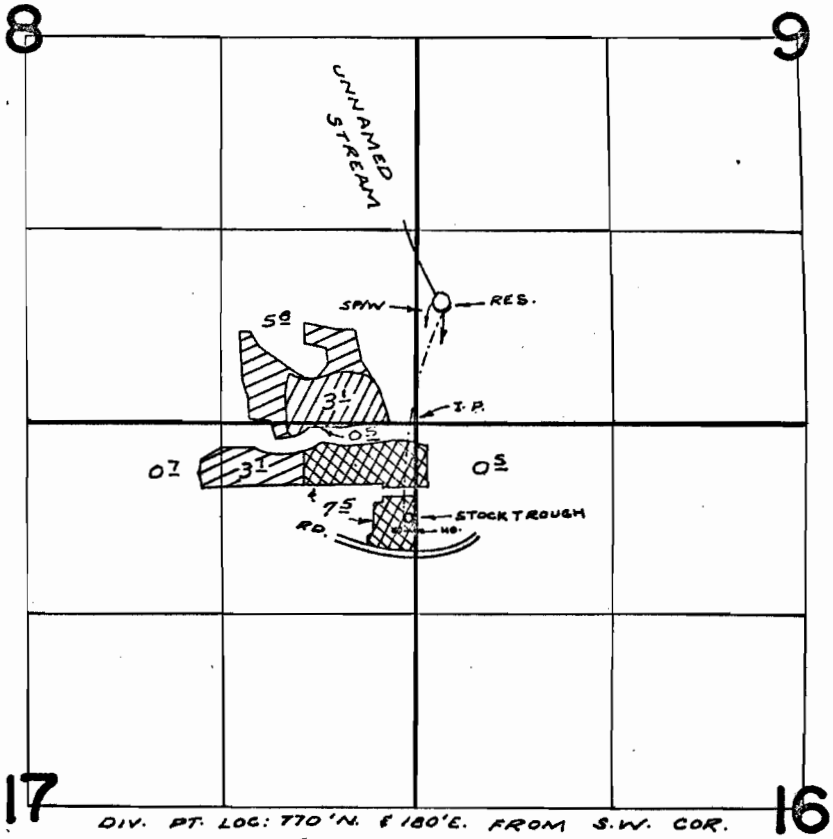

DIV. PT. LOC: 770'N. & 180'E. FROM S.W. COR. SEC. 9

PRIMARY, STREAM PER. 30175

PRIMARY, STREAM & RES. PER. 33875

SUPPLEMENTAL, RES. PER. 33875

FINAL PROOF SURVEY
UNDER

40504 R-45372 30175 R-5362

Application No. 45372 Permit No. 33875

IN NAME OF

LLOYD SLETTO

Surveyed SEPT. 5 1968, by V. GARNER
JULY 26 1972, R.G. MUCKEN

1968-E & 1972-L