


T.9S.R.2E.W.M.

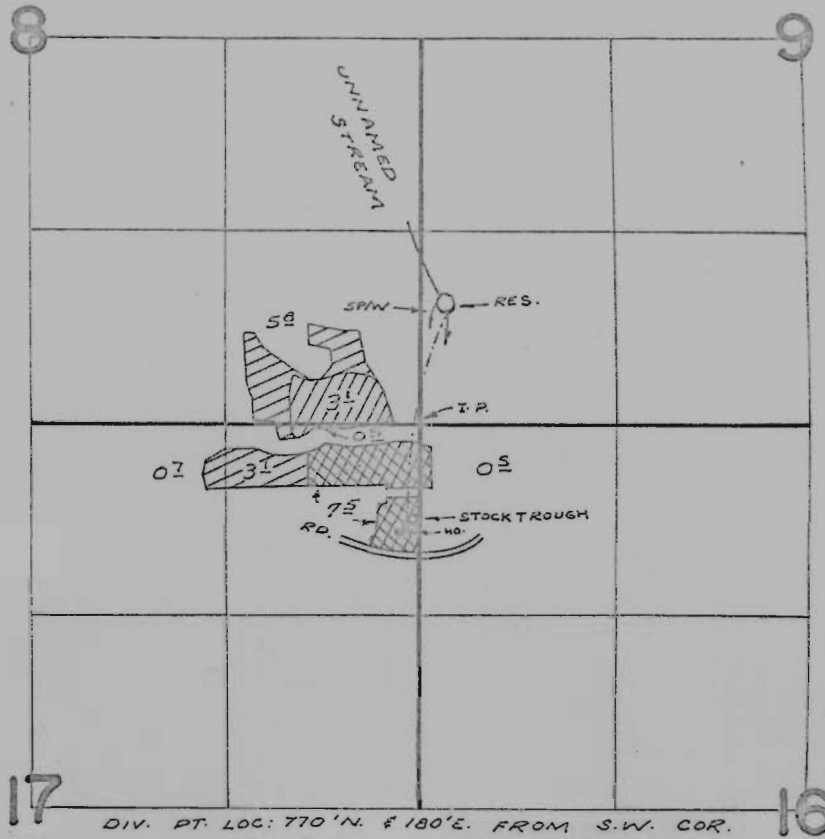

DIV. PT. LOC: 770' N. & 180' E. FROM S.W. COR. SEC. 9

- PRIMARY, STREAM PER. 30175
- PRIMARY, STREAM & RES. PER. 33875
- SUPPLEMENTAL, RES. PER. 33875

FINAL PROOF SURVEY
UNDER

40504 30175
R-45372 R-5362
Application No. 45373 Permit No. 33875
IN NAME OF

..... LLOYD SLETTO

Surveyed SEPT. 5 1968, by V. GARNER
JULY 26 1972, R.G. MUCKEN