


G-3164
42527

T.1N. R.27E. W.M.

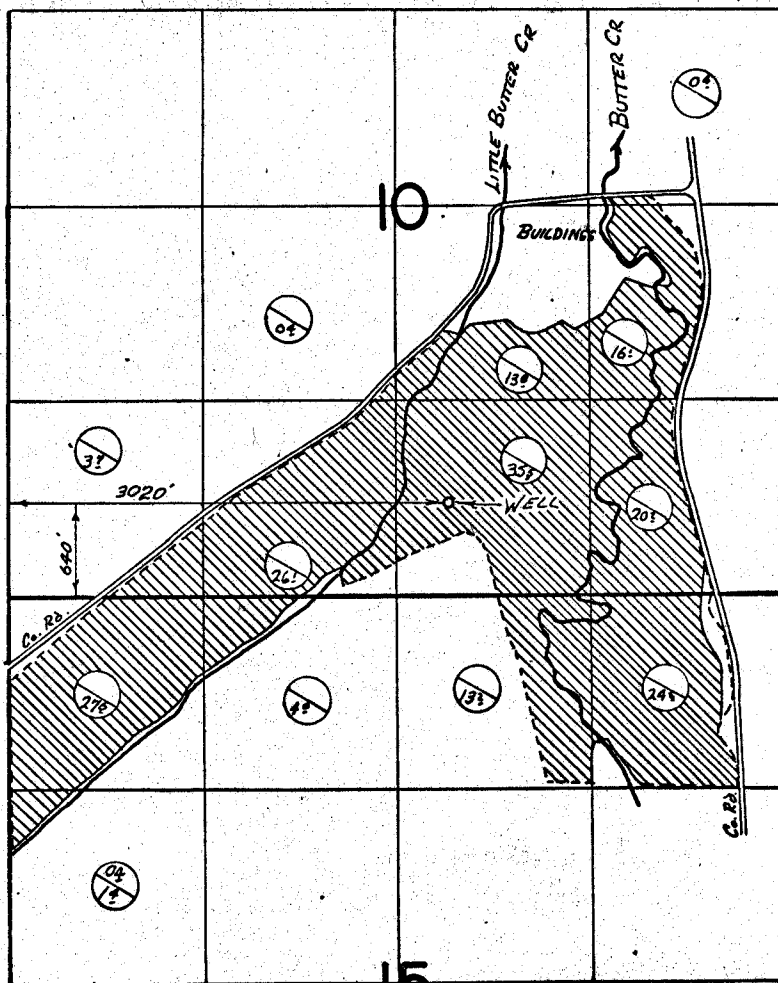

FINAL PROOF SURVEY UNDER

Application No. G-3516... Permit No. G-3164...
IN NAME OF

LEO ASHBECK

Surveyed APRIL 18 1974, by T. J. PAUL