


G-4106
42528

T.2S., R.26E., W.M.

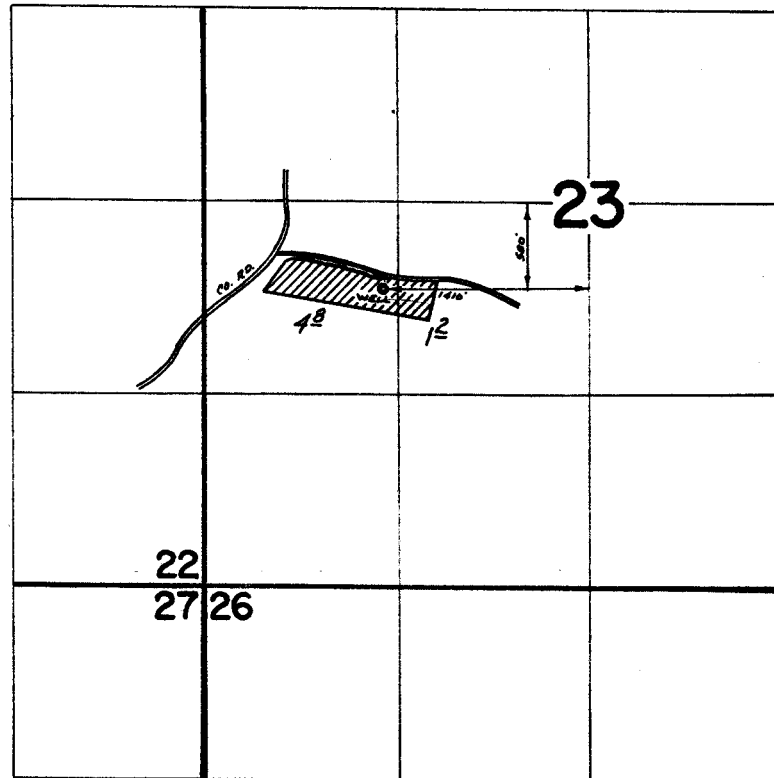

FINAL PROOF SURVEY
UNDER

Application No. G-4349 Permit No. G-4106
IN NAME OF

DAIL TURNER & ROBERT SCHULTZ

Surveyed May 10 1974, by D. Dorby