


T.3S., R.27E., W.M.

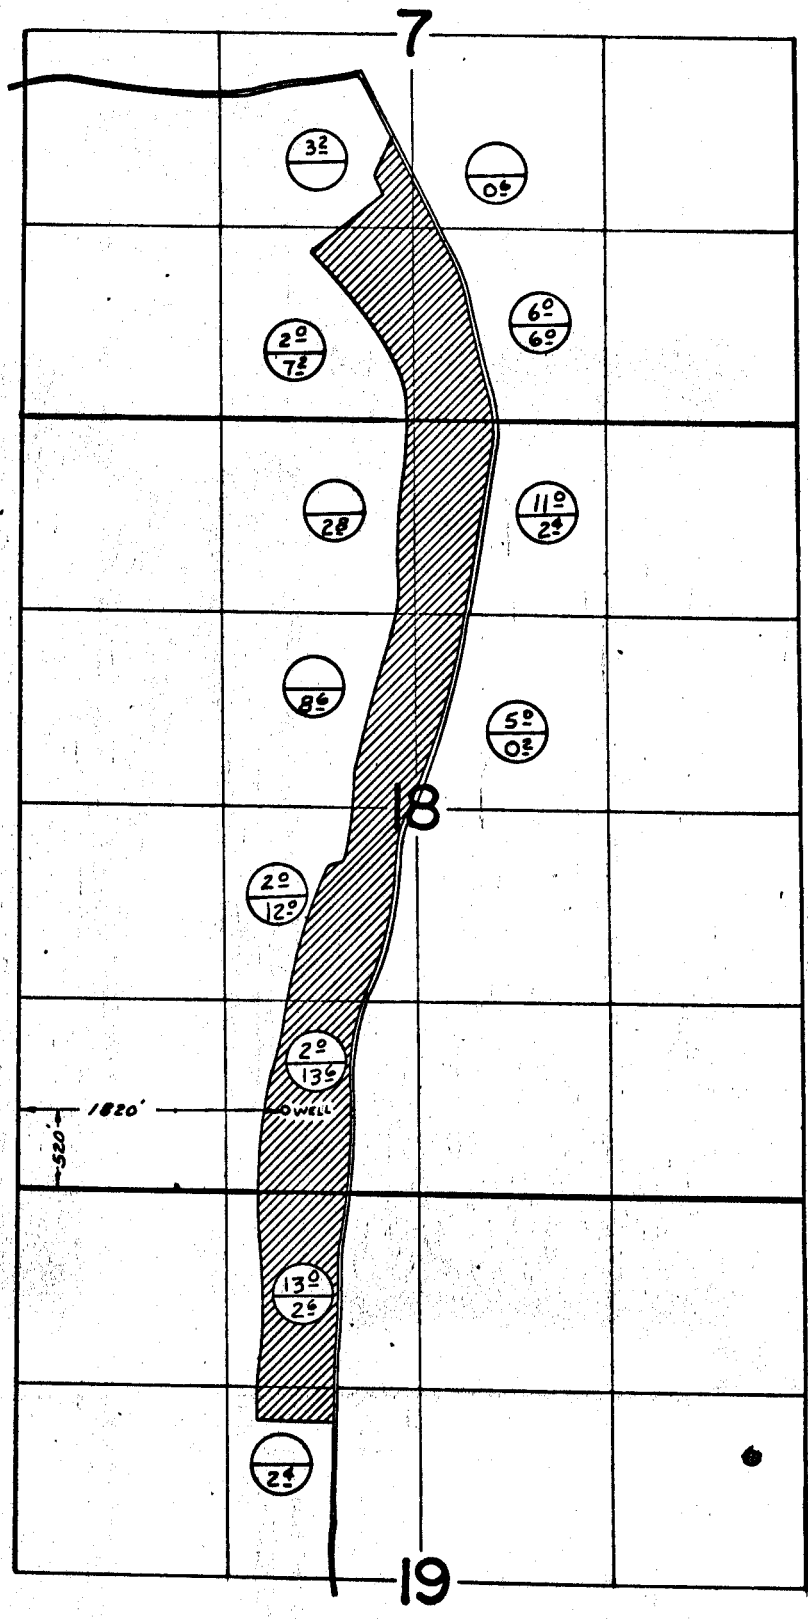

FINAL PROOF SURVEY
UNDER

Application No. G-4588 Permit No. G-4315
IN NAME OF
BEAMER RANCH

Surveyed May 10, 1974, by D. Norby

 Supplemental
 Primary