


T.3S., R.26E., W.M.

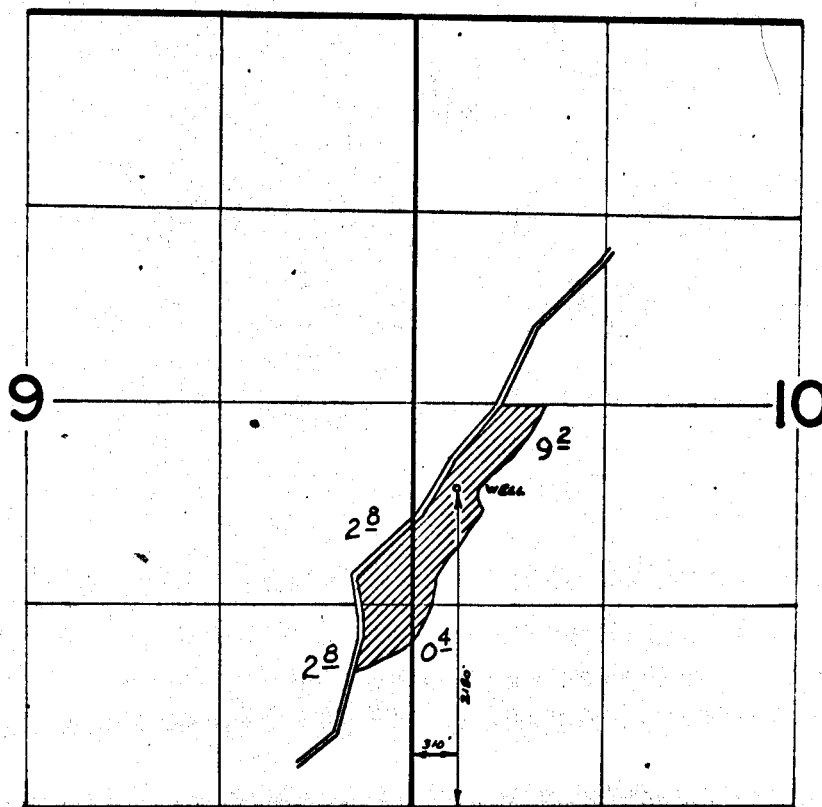

FINAL PROOF SURVEY
UNDER

Application No. G-4709 Permit No. G-4426
IN NAME OF

C. H. PRIVETT

Surveyed May 17, 1974, by *D. Dorby*