
G-4483
42531

T. 2S., R. 27 & 28E., W.M.

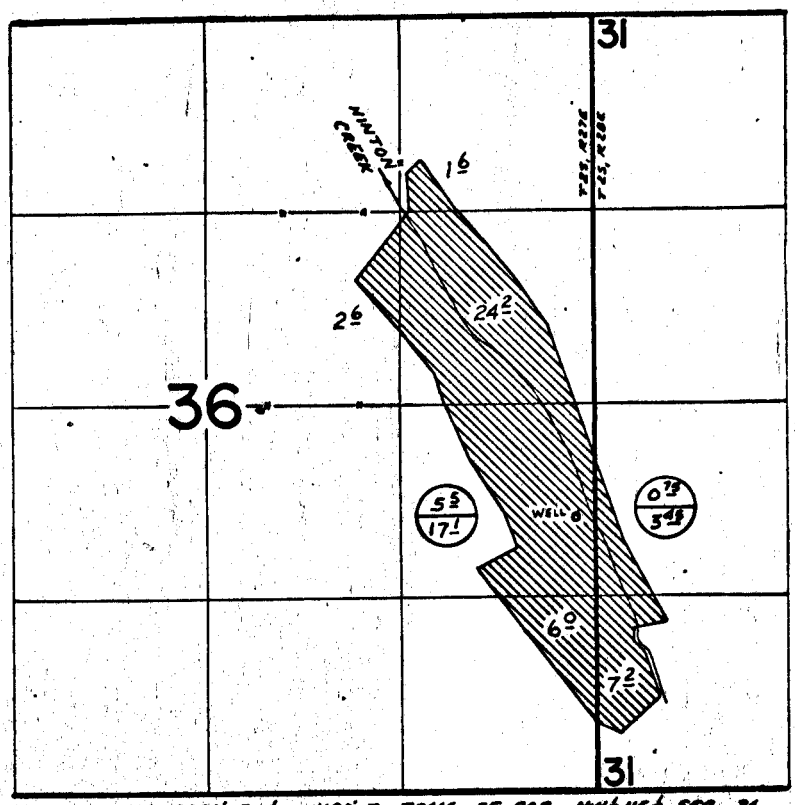

WELL LOCATED: 2090' S & 1180' E FROM SE COR. NW¼ NE¼ SEC. 36.

⊖ SUPPLEMENTAL
PRIMARY

FINAL PROOF SURVEY
UNDER

Application No. G-4759 Permit No. G-4483
IN NAME OF

MITCHELL C. & TERRYL ANN ASHBECK

Surveyed May 16 19 74, by D. Darby

PTS-1994-A