


33412
42532

T.4S., R.28E., W.M.

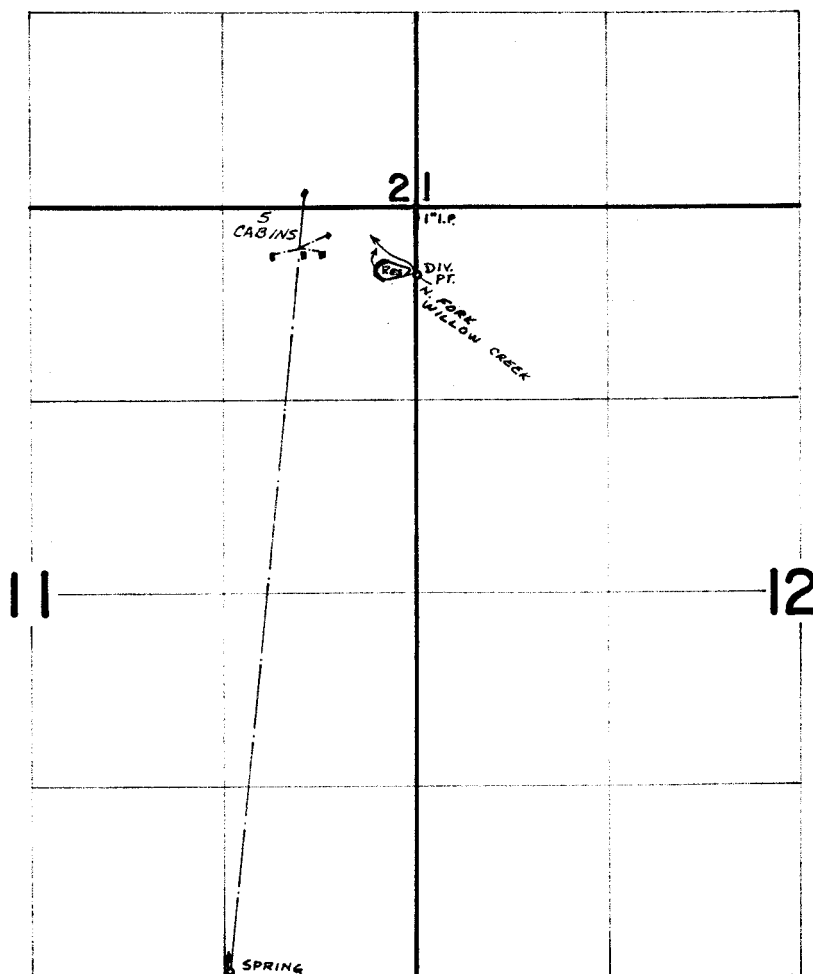

DIV. PT. LOCATED: 460' S & 10' E FROM NE COR. SEC. 11.
SPRING LOCATED: 50' N & 1280' W FROM SE COR. SEC. 11.

FINAL PROOF SURVEY
UNDER

44204

33412

44288

33413

Application No. R-45530 Permit No. R-5286
IN NAME OF

EARL J. AND MARGARET C. BLAKE

Surveyed May 14 1974, by D. Dorby