


# T.1N. R.18E. W. M.

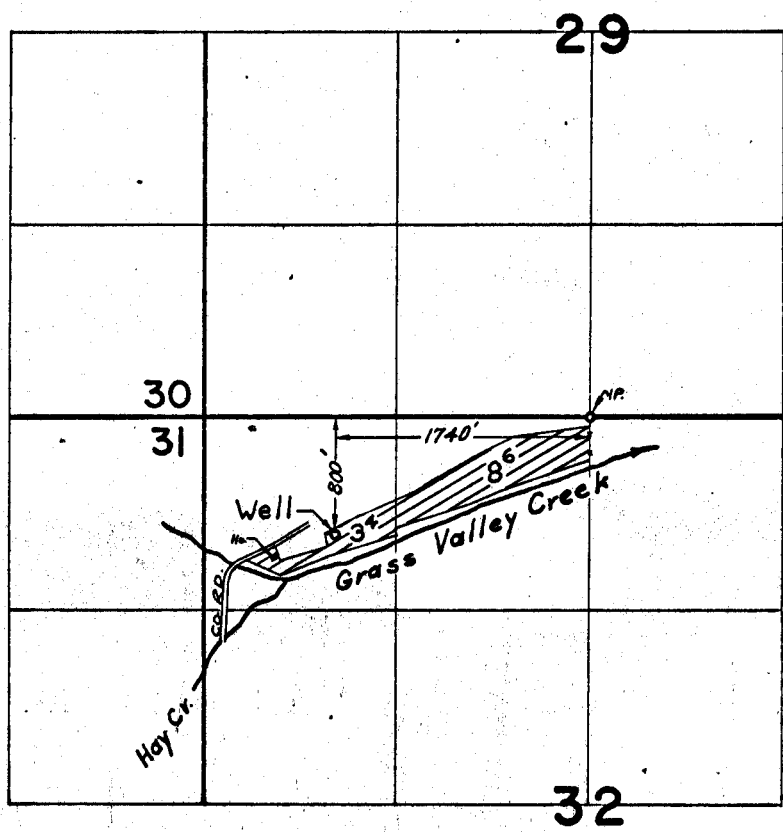

## FINAL PROOF SURVEY UNDER

Application No. G-5613 Permit No. G-5166  
IN NAME OF

ERNEST E. & MARJORY H. SHULL

Surveyed APRIL 1, 1974, by L. E. GOULD