


T.1 S. R.38 E. W.M.

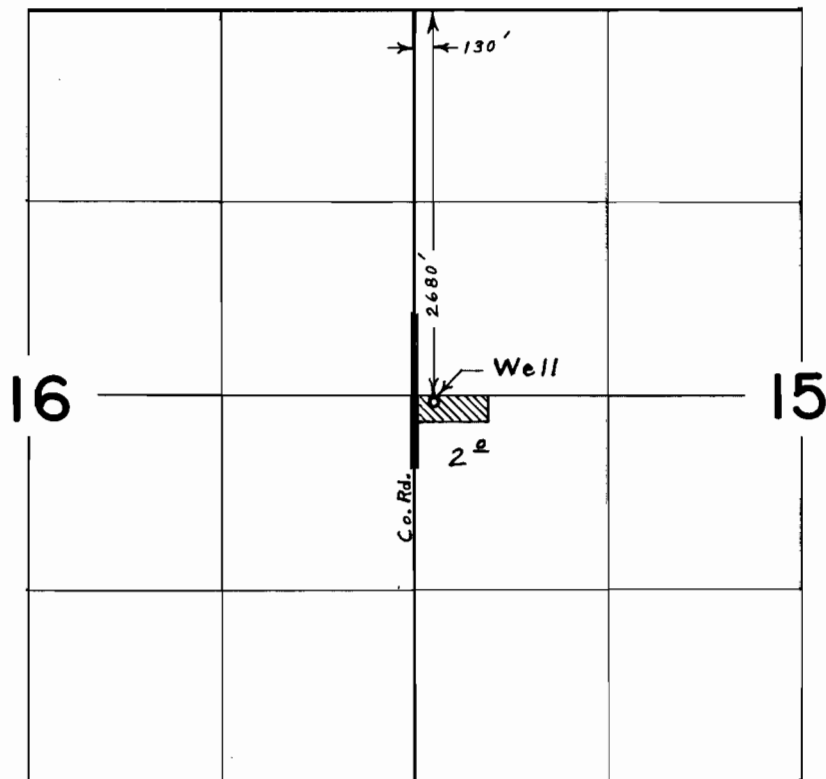

FINAL PROOF SURVEY
UNDER

Application No. G-5438 Permit No. G-5155
IN NAME OF

FRED R. FREELS

Surveyed Sept. 13, 1974, by Larry H. Nunn