


T. 1 S., R. 39 E., W. M.

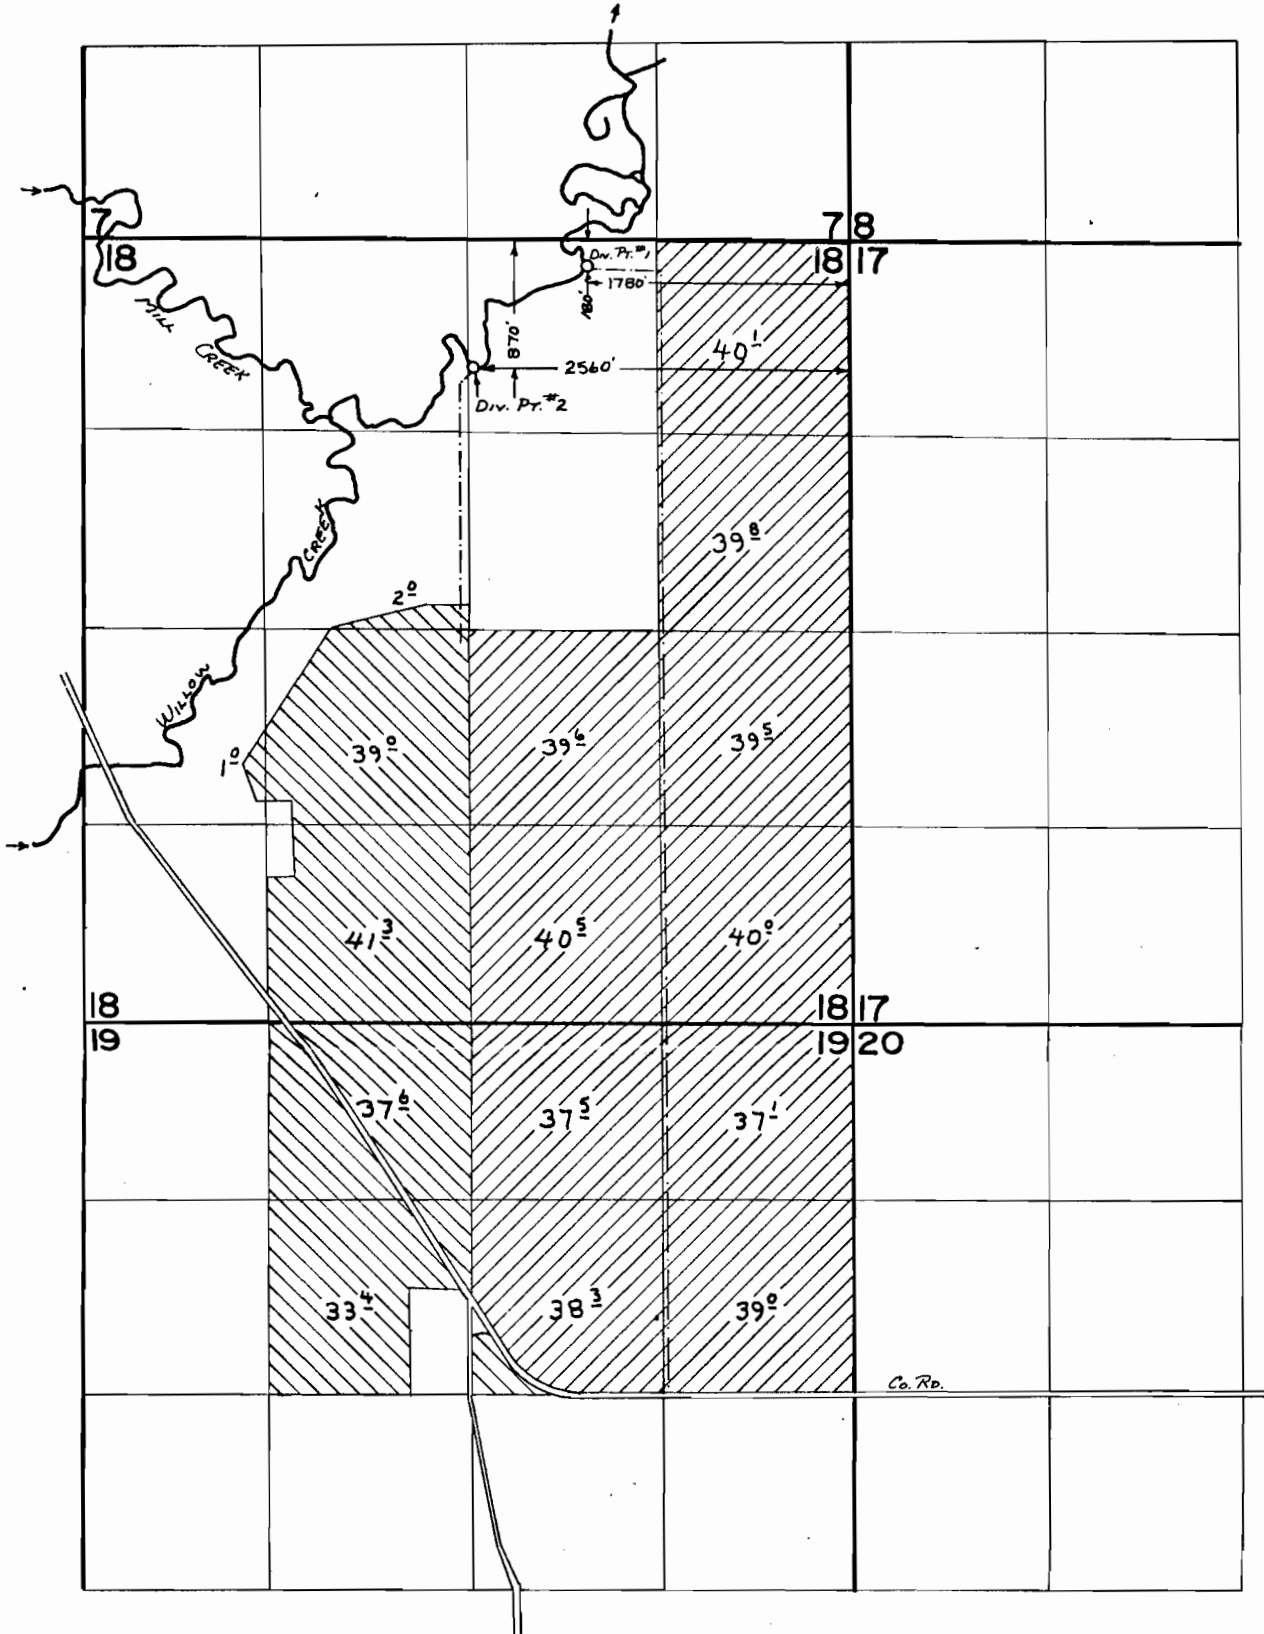

**FINAL PROOF SURVEY**  
UNDER

Application No. 41455 Permit No. 30952  
IN NAME OF

ESTATE OF THURMAN S. TEETER, SR.

Surveyed Sept. 11, 1974 by L. H. NUNN.