


T.3 S. R.40 E. W.M.

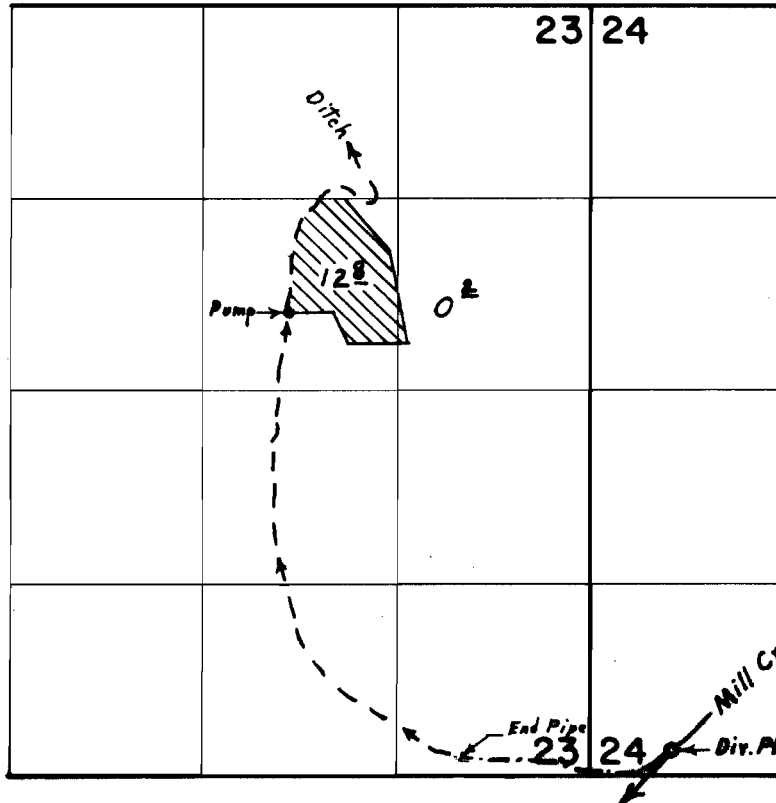

Div. Pt. located 180' N. & 560' E. from S.W. Cor. Sec. 24

FINAL PROOF SURVEY
UNDER

Application No. 42745 Permit No. 31927
IN NAME OF

FRANK L. NIMS

Surveyed Sept. 14, 1974, by L. E. Gould