


T.3 S. R.40 E. W.M.

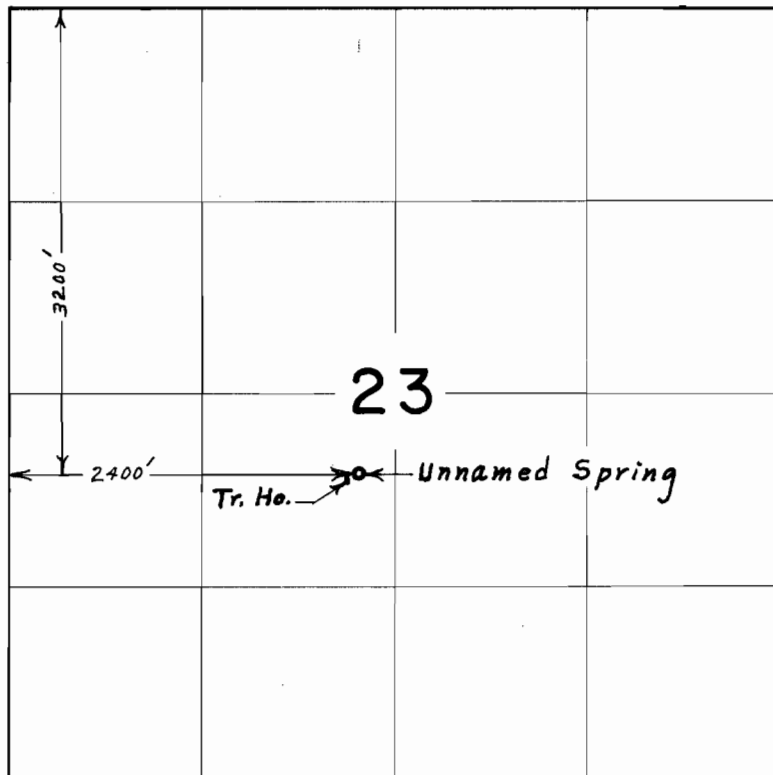

FINAL PROOF SURVEY
UNDER

Application No. 42953 Permit No. 32089
IN NAME OF

FRANK L. NIMS

Surveyed Sept. 14, 1974, by L. E. Gould