


T.1N.,R.39E.,W.M.

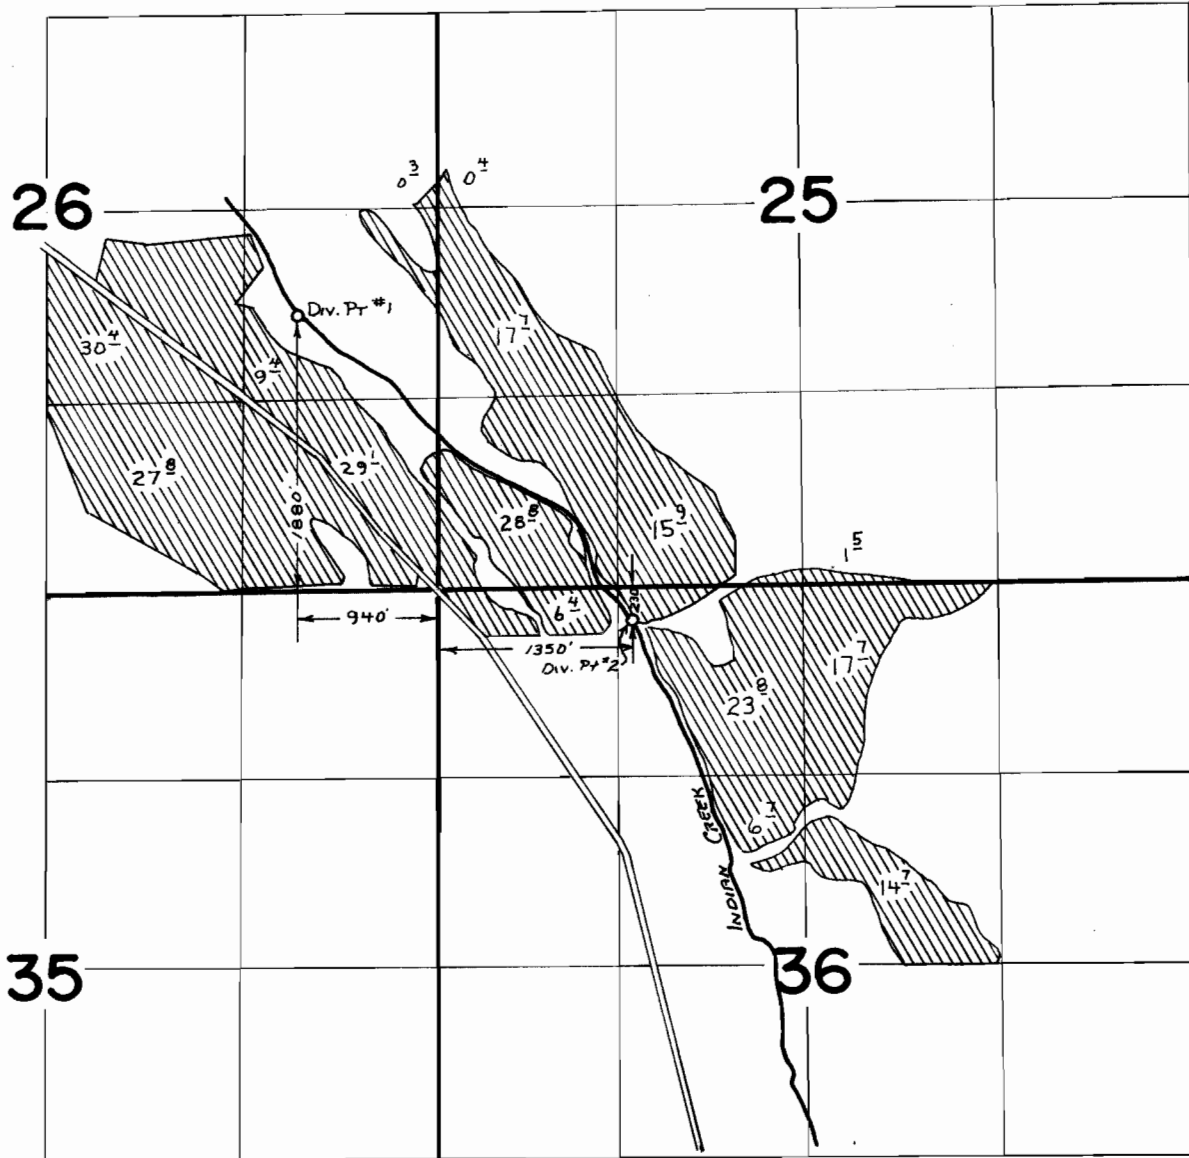

FINAL PROOF SURVEY UNDER

Application No. 42997. Permit No. 32125.
IN NAME OF

JAMES H. MCCLURE

Surveyed SEPT. 12. 19.74, by L. H. NUNN.