


T.1S.,R.38E.,W.M.

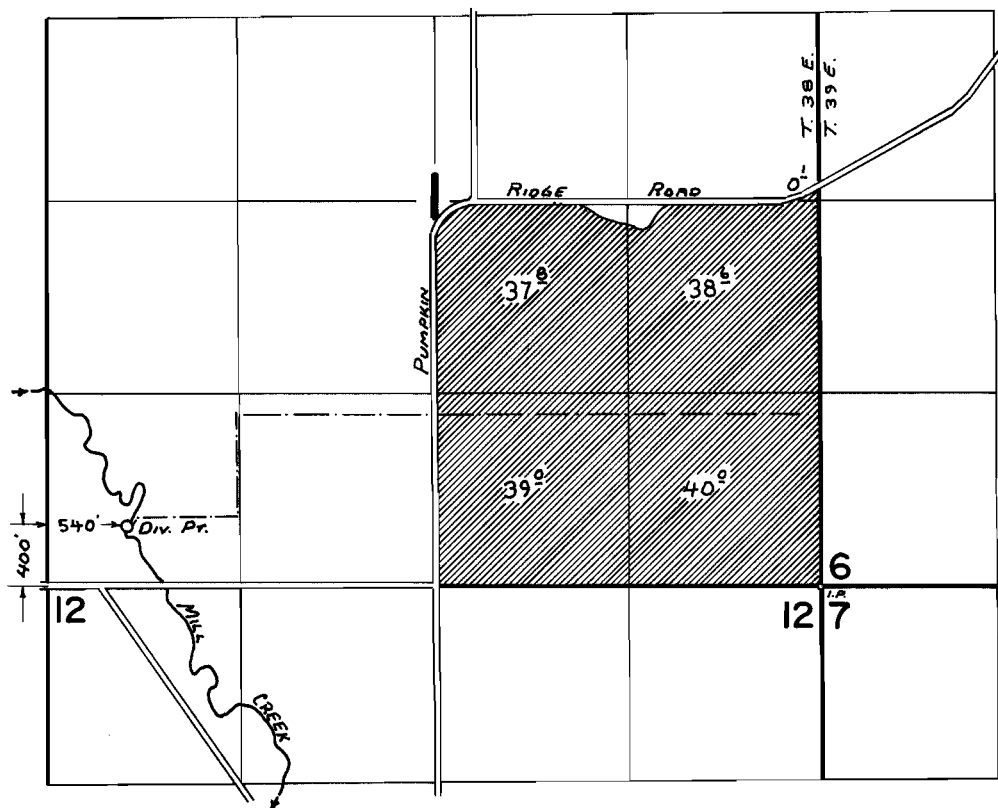

FINAL PROOF SURVEY
UNDER

Application No. 47957 Permit No. 35606
IN NAME OF

LAWRENCE R. & ELEANOR E. STARR

Surveyed SEPT. 11 1974, by L. H. NUNN