


T.3 S. R.40 E. W.M.

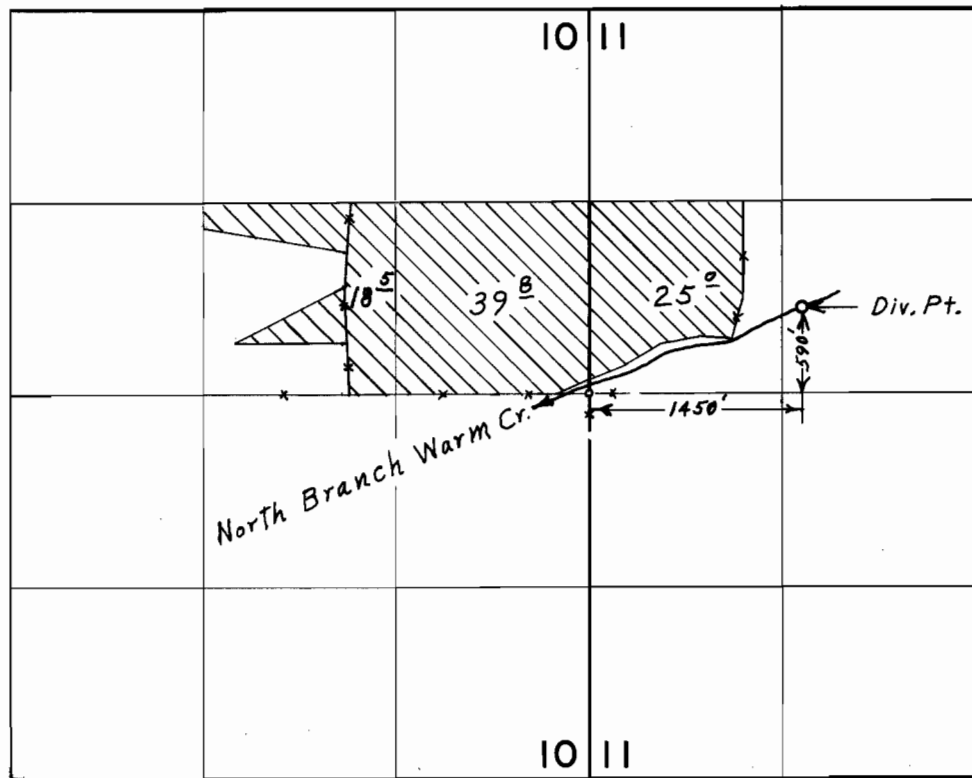

FINAL PROOF SURVEY
UNDER

Application No. 42831 Permit No. 3666
IN NAME OF

DON E. & JOAN J. ROBINSON

Surveyed Sept. 18 1974, by L. E. Gould