


T.1S.,R.38E.,W.M.

PRIMARY } FOR A. #46258
 SUPPLEMENTAL }
 PRIMARY } FOR A. #46280
 SUPPLEMENTAL }

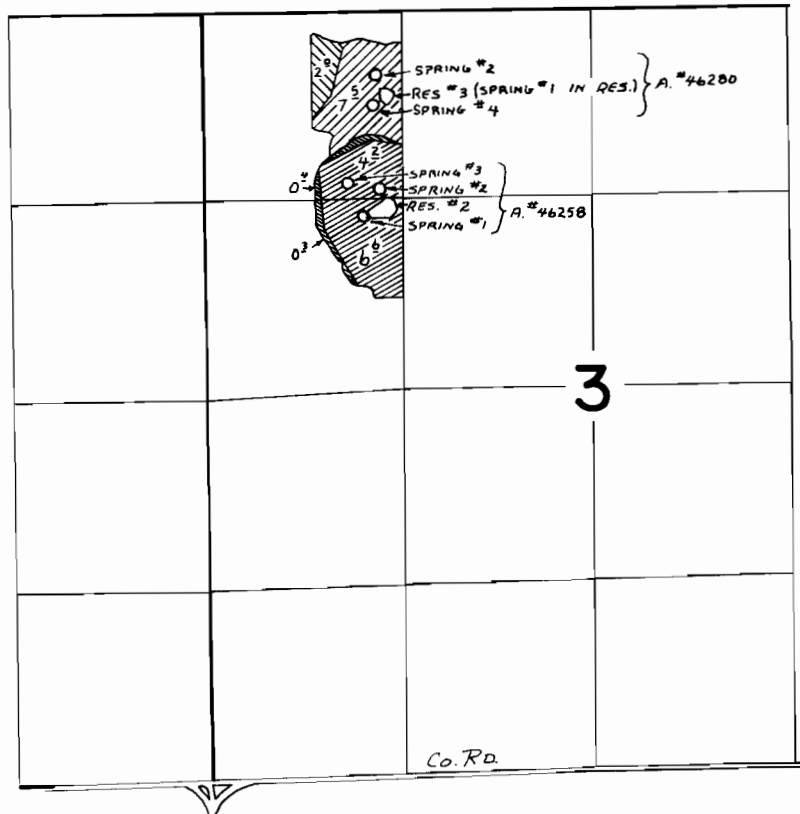

A. #46280

A. #46258

Spring #1 Res. #3 4690' N. & 1250' E.,
 Spring #2 4850' N. & 1190' E.,
 Spring #4 4640' N. & 1160' E.

RES #2 - 3920' N AND 1310' E
 SPRING #1 - 3840' N AND 1100' E
 SPRING #2 - 4040' N AND 1210' E
 SPRING #3 - 4090' N AND 990' E

ALL FROM SW COR. SEC. 3

FINAL PROOF SURVEY

UNDER

R-46257
 46258
 46280

R-5502
 34559
 34573

Application No. R-46299 Permit No. R-5508.
 IN NAME OF

FLOYD A. FEIK

Surveyed SEPT. 11, 1974, by L. H. NUNN.