


T.1S.,R.38E.,W.M.


 PRIMARY
 SUPPLEMENTAL
 PRIMARY
 SUPPLEMENTAL

FOR A. #46258
 FOR A. #46280

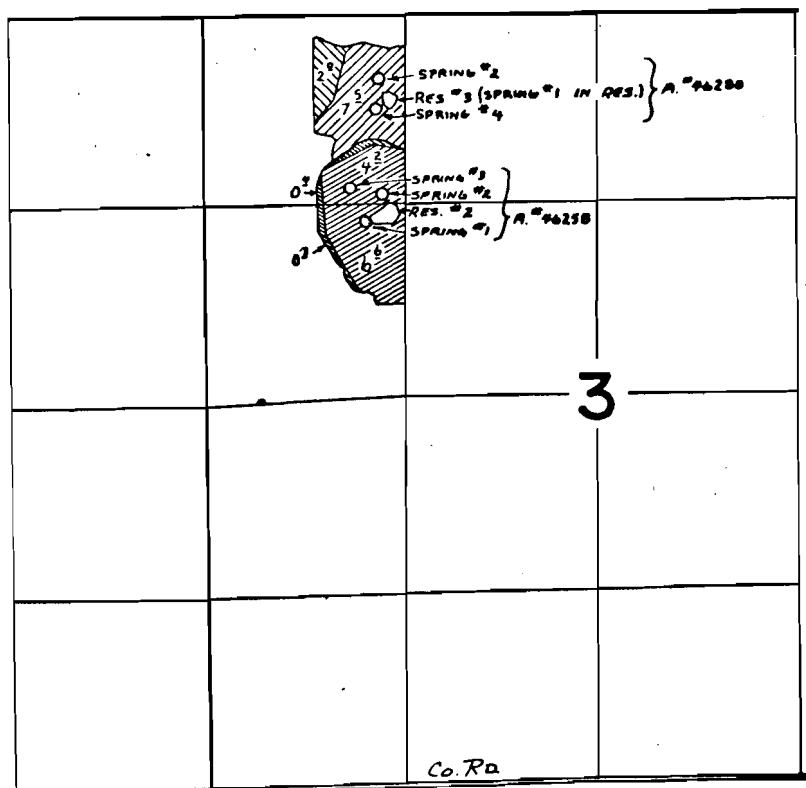

A. #46280

A. #46258

Spring #1 Res. #3 4690' N. 1250' E.,
 Spring #2 4850' N. 1190' E.,
 Spring #4 4690' N. 1160' E.

RES #2 - 3920' N AND 1310' E
 SPRING #1 - 3840' N AND 1100' E
 SPRING #2 - 4040' N AND 1210' E
 SPRING #3 - 4090' N AND 980' E

ALL FROM SW COR. SEC. 3

FINAL PROOF SURVEY

UNDER

R-46257

R-5502

46258

34559

46280

34573

Application No. R-46299 Permit No. R-5508.

IN NAME OF

FLOYD A. FEIK

Surveyed SEPT. 11. 1974, by L. H. NUNN.