


T.3 S, R.40 E. W.M.

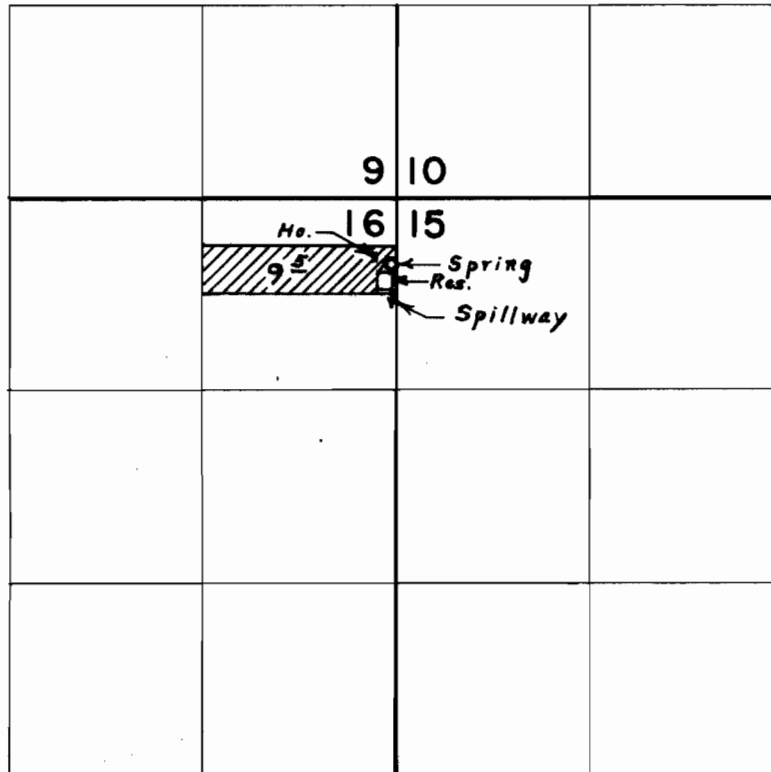

Spring loc. 450' S. & 30' W. from N. E. Corner Section 16

FINAL PROOF SURVEY UNDER

Application No. 49412 Permit No. R-6010
49413 37027
IN NAME OF

RICHARD CHARLES NICHOLSON

Surveyed Sept. 13, 1974, by L. E. Gould