


T.3 S. R.40 E. W.M.

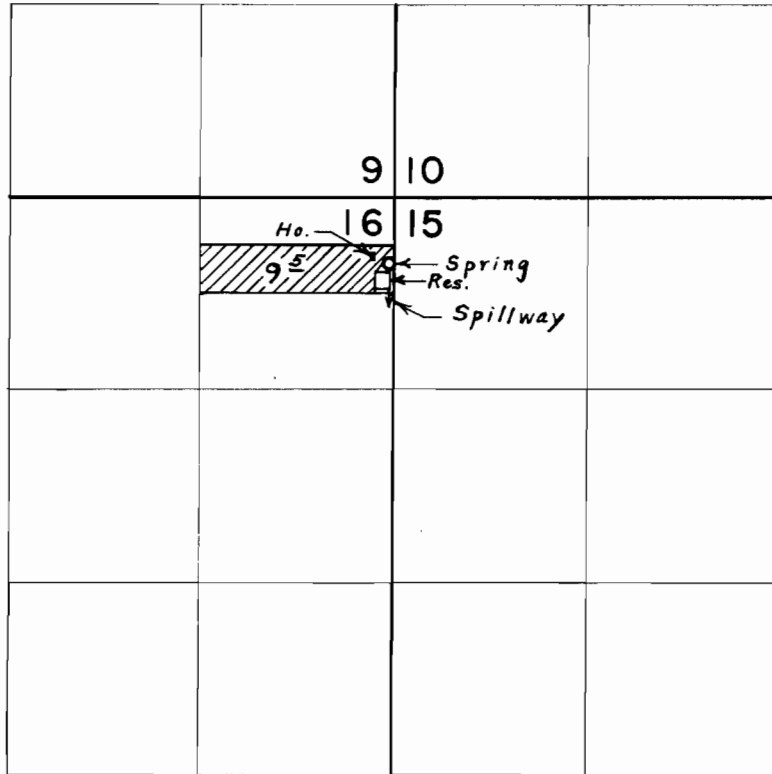

Spring loc. 450' S. & 30' W. from N. E. Corner Section 16

FINAL PROOF SURVEY
UNDER

Application No. ⁴⁹⁴¹²~~49413~~ Permit No. ^{R-6010}~~37027~~
IN NAME OF

RICHARD CHARLES NICHOLSON

Surveyed Sept. 13, 1974, by L. E. Gould