


# T.4S.R.13E.W.M.

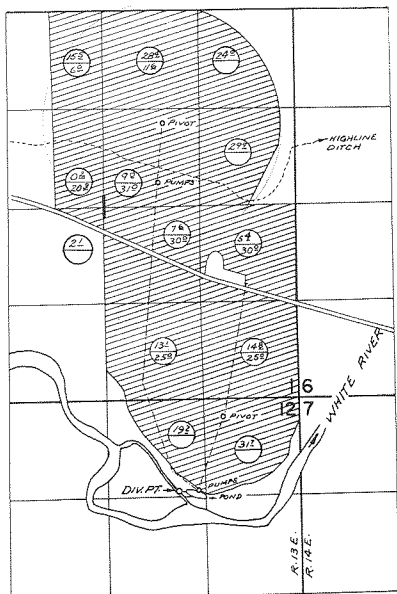

Div. Pt. Loc: 1430'N. 6930'E. FROM CENTER SEC. 12

○ PRIMARY  
 ⊖ SUPPLEMENTAL

## FINAL PROOF SURVEY UNDER

Application No. 43338..... Permit No. 32376.....  
 IN NAME OF

..... GENE REYNOLDS .....

Surveyed SEPT. 12, 1974, by D. NORBY.....