


T.2N.,R.12E.,W.M.

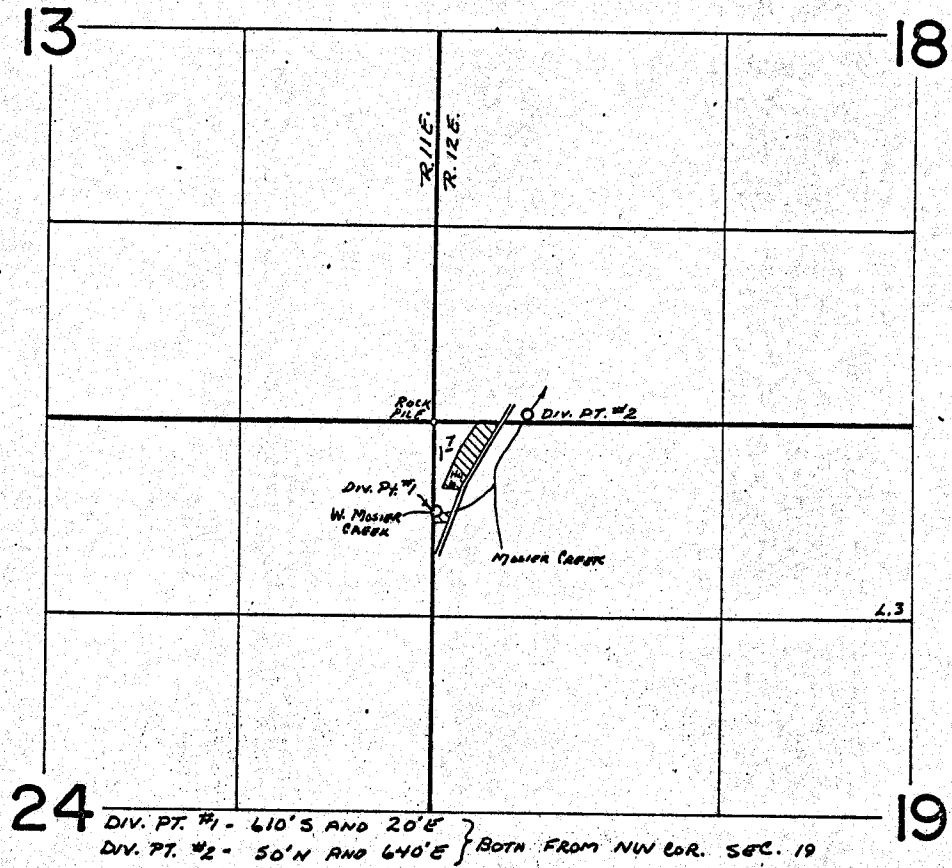

FINAL PROOF SURVEY
UNDER

Application No. 49071 Permit No. 36813
IN NAME OF

DENNIS G. & KAREN M. BAILEY

Surveyed APRIL 22 1974, by D. NORBY