


T.I.S.R.12E.W.M.

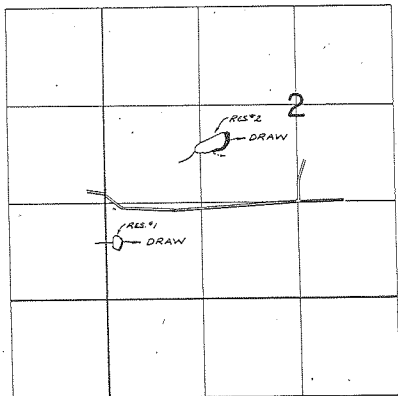

FINAL PROOF SURVEY  
UNDER

Application No. ~~R-46464~~ *R-46464* Permit No. ~~R-5539~~ *R-5540*  
IN NAME OF

*JESSE P. MILLER*

Surveyed *APR. 23 1974*, by *D. NORBY*