


T.8S.,R.16E.,W.M.

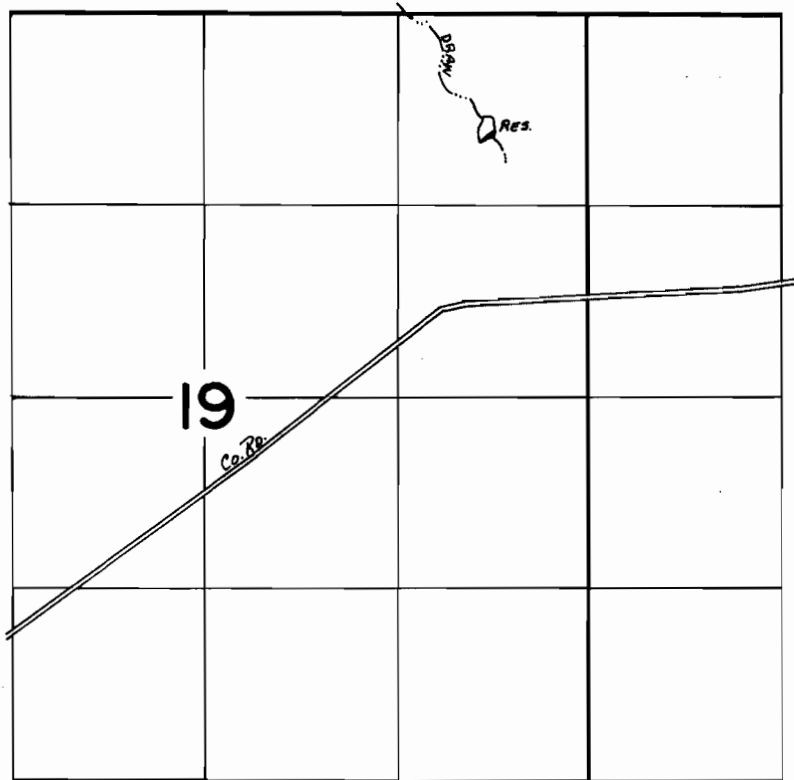

**FINAL PROOF SURVEY**  
UNDER

Application No. ~~R-48786~~ Permit No. ~~R-5694~~  
IN NAME OF

..... JOHN R. HASTINGS .....

Surveyed Sept. 11, 1974, by D. NORBY.....