


# T.8S.R.16E.W.M.

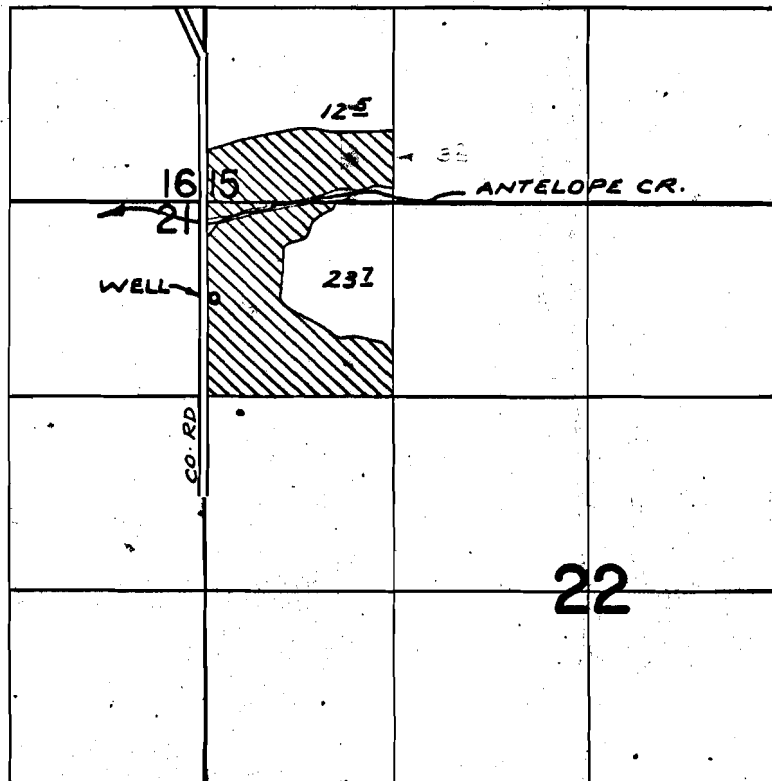

WELL LOC: 670' N. & 60' E FROM S.W. COR. NW 1/4 NW 1/4 SEC. 22

## FINAL PROOF SURVEY UNDER

Application No. ~~G-4254~~ Permit No. ~~G-4010~~  
IN NAME OF

ROBERT HASTINGS

Surveyed SEPT. 11, 1974, by D. NORBY

*J-4010*  
R.G.M.  
112-35