


T.8 S. R.16 E. W.M.

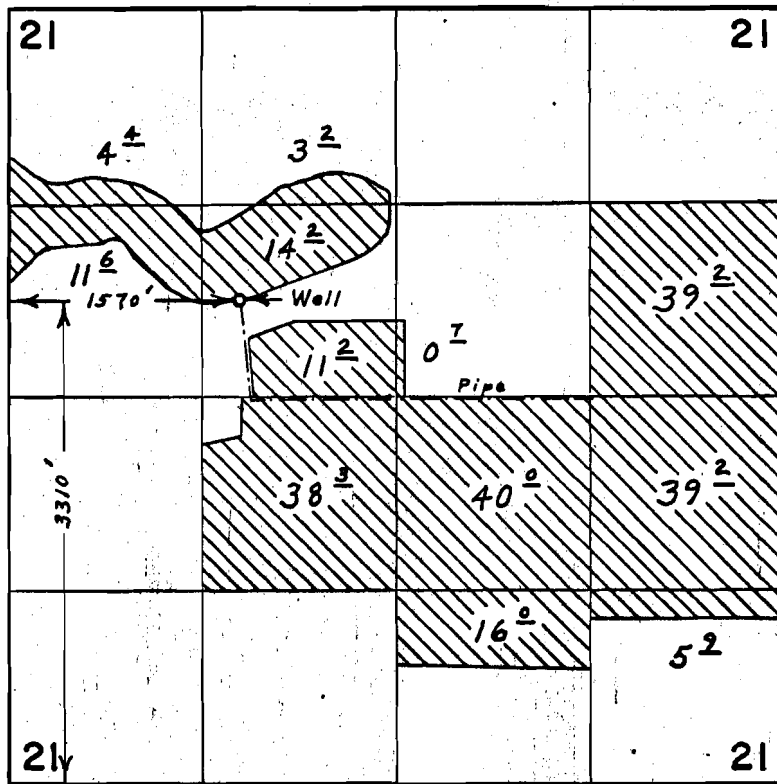

FINAL PROOF SURVEY UNDER

Application No. G-5175 Permit No. G-4822
IN NAME OF

E. O. BORTHWICK

Surveyed Sept. 11, 1974, by D.M. Norkey

G-4822
21 41063 172-34 L86