


T.8S.R.16E.W.M.

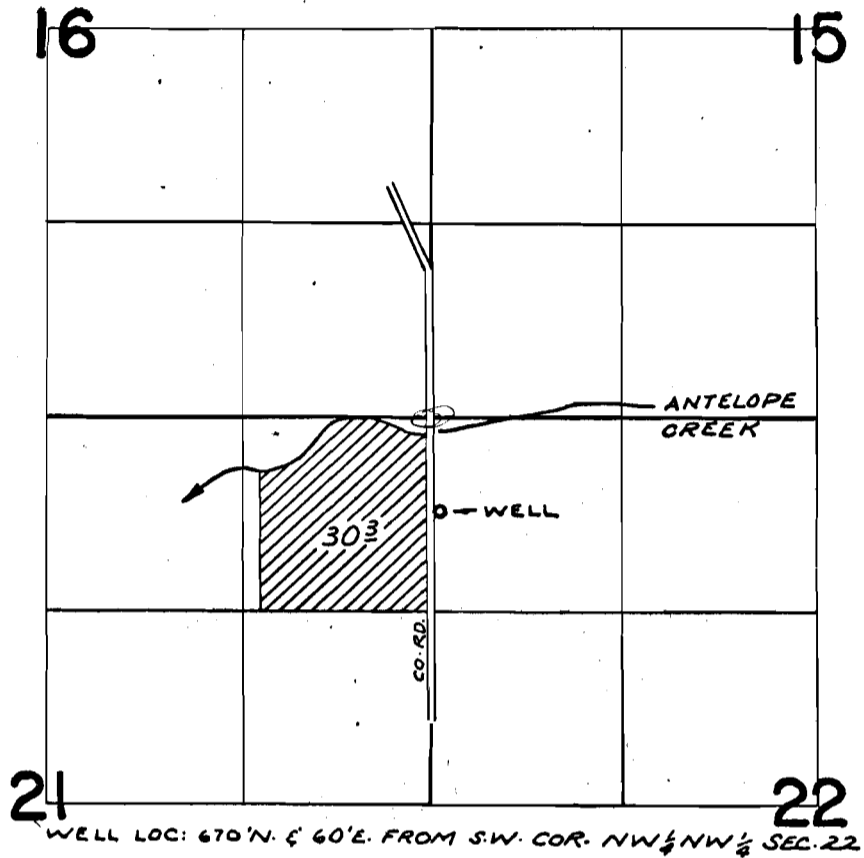

FINAL PROOF SURVEY UNDER

Application No. G-5222 Permit No. G-5081
IN NAME OF

JOHN R. HASTINGS

Surveyed SEPT. 11, 1974, by D. NORBY

G-5081
R.G.M.
172-36