


T 9 S., R 22 E., W.M. Lot 1, Sec. 1
T 8 S., R 23 E., W.M. Lot 4, Sec. 31

P 34756
42570

RECEIVED
OCT 31 1969
STATE ENGINEER
SALEM, OREGON

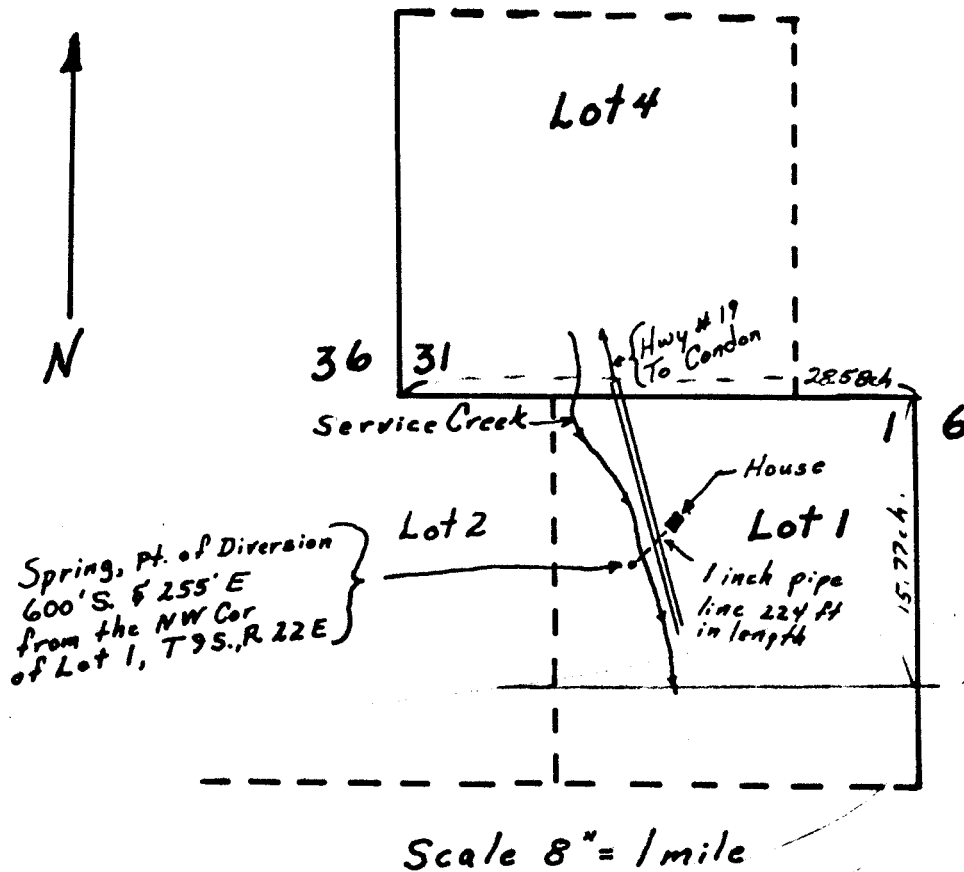

Map approved by: Alta Marie Spaulding

APPLICATION NO. 46520
Permit No. 34756