# T.5S. R.4.W. W.M.

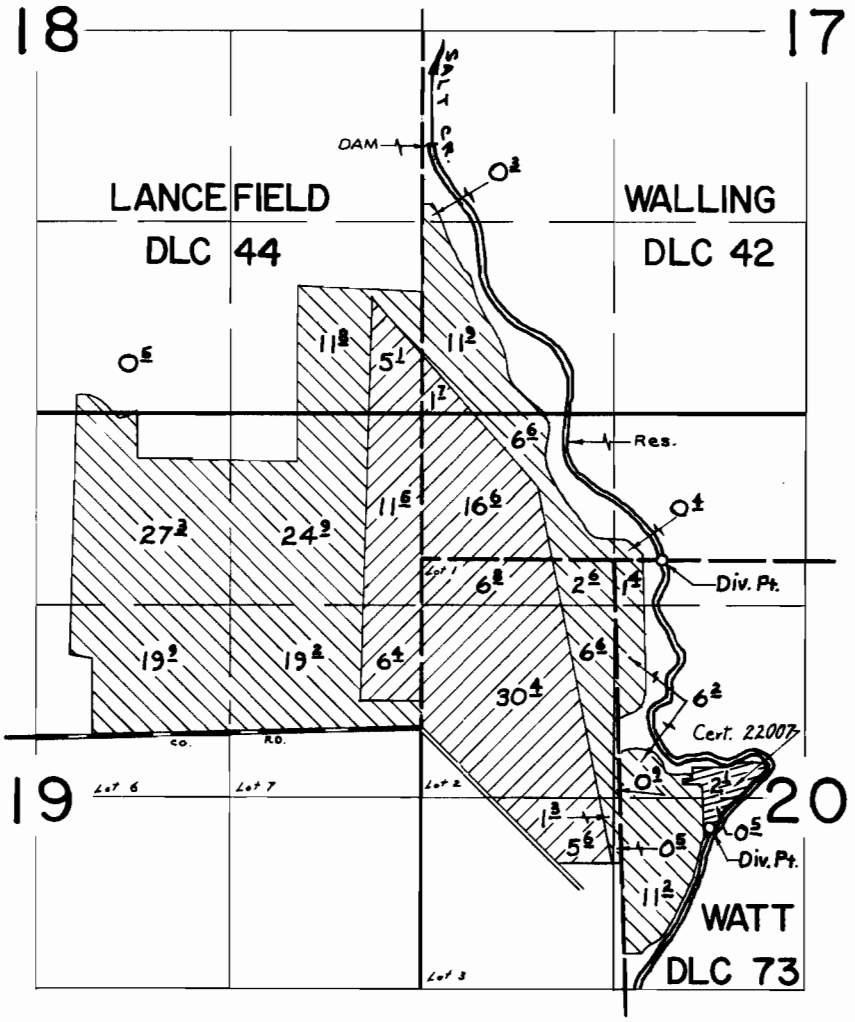


Div. Pts. Loc: 670'S. & 1980'E, 1180'N. & 1650'E., Dam - 4020'N. & 70'E.
all from SE. corner Lancefield DLC 44

## FINAL PROOF SURVEY
UNDER

Application No. R-41605, 41606, 46494 Permit No. R-4713, 31196 — Primary, 34745 — Primary, Supplemental

IN NAME OF

ROBERT & STUART LANCEFIELD

Surveyed MAY 29, 1973, by R. G. MUCKEN

DFQ-ILL-108 & DFQ-3D-72