T.3 & 4 S. R.3 W. W.M.

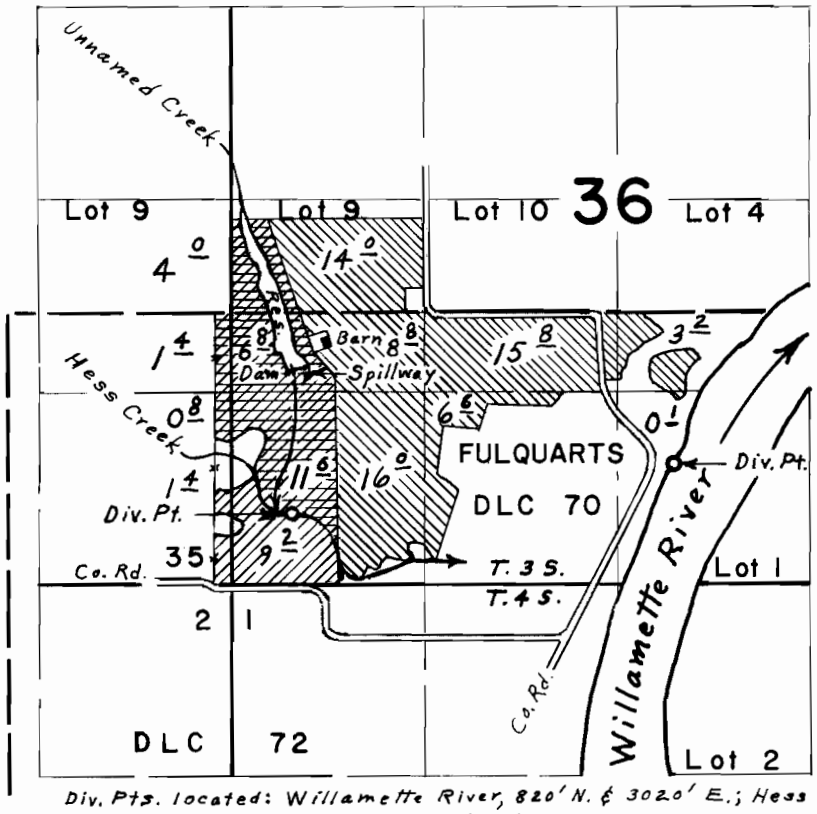

Div. Pts. located: Willamette River, 820' N. & 3020' E.; Hess Creek, 480' N. & 420' E.; Res. 1470' N. & 420' E.; all from S.W. Cor. Sec. 36

Willamette River
Hess Creek
Unnamed Stream & Reservoir

FINAL PROOF SURVEY

UNDER

39664 R-43976 Application No. 43977 Permit No. 32279 29466 R-4944

IN NAME OF

DR. GLEN E. SCHWENKE

March 28, 1973

Surveyed Sept. 30, 1971, by L. E. Gould

DFQ-4LL-12