


I, William L. Wales, a Registered Professional Engineer, of Klamath Falls, Oregon, and also being duly appointed and acting Watermaster for District No. 19, of the State of Oregon do hereby certify that the entire area shown shaded on the accompanying map has been irrigated with water diverted through the canals shown from Wood River under Application No. 488, Permit No. 309, in the name of the Meadows Drainage District, prior to this date, January 5th, 1954.

William L. Wales

Registered Professional Engineer
Oregon No. 1347. Date of Registration, Aug. 4, 1927.

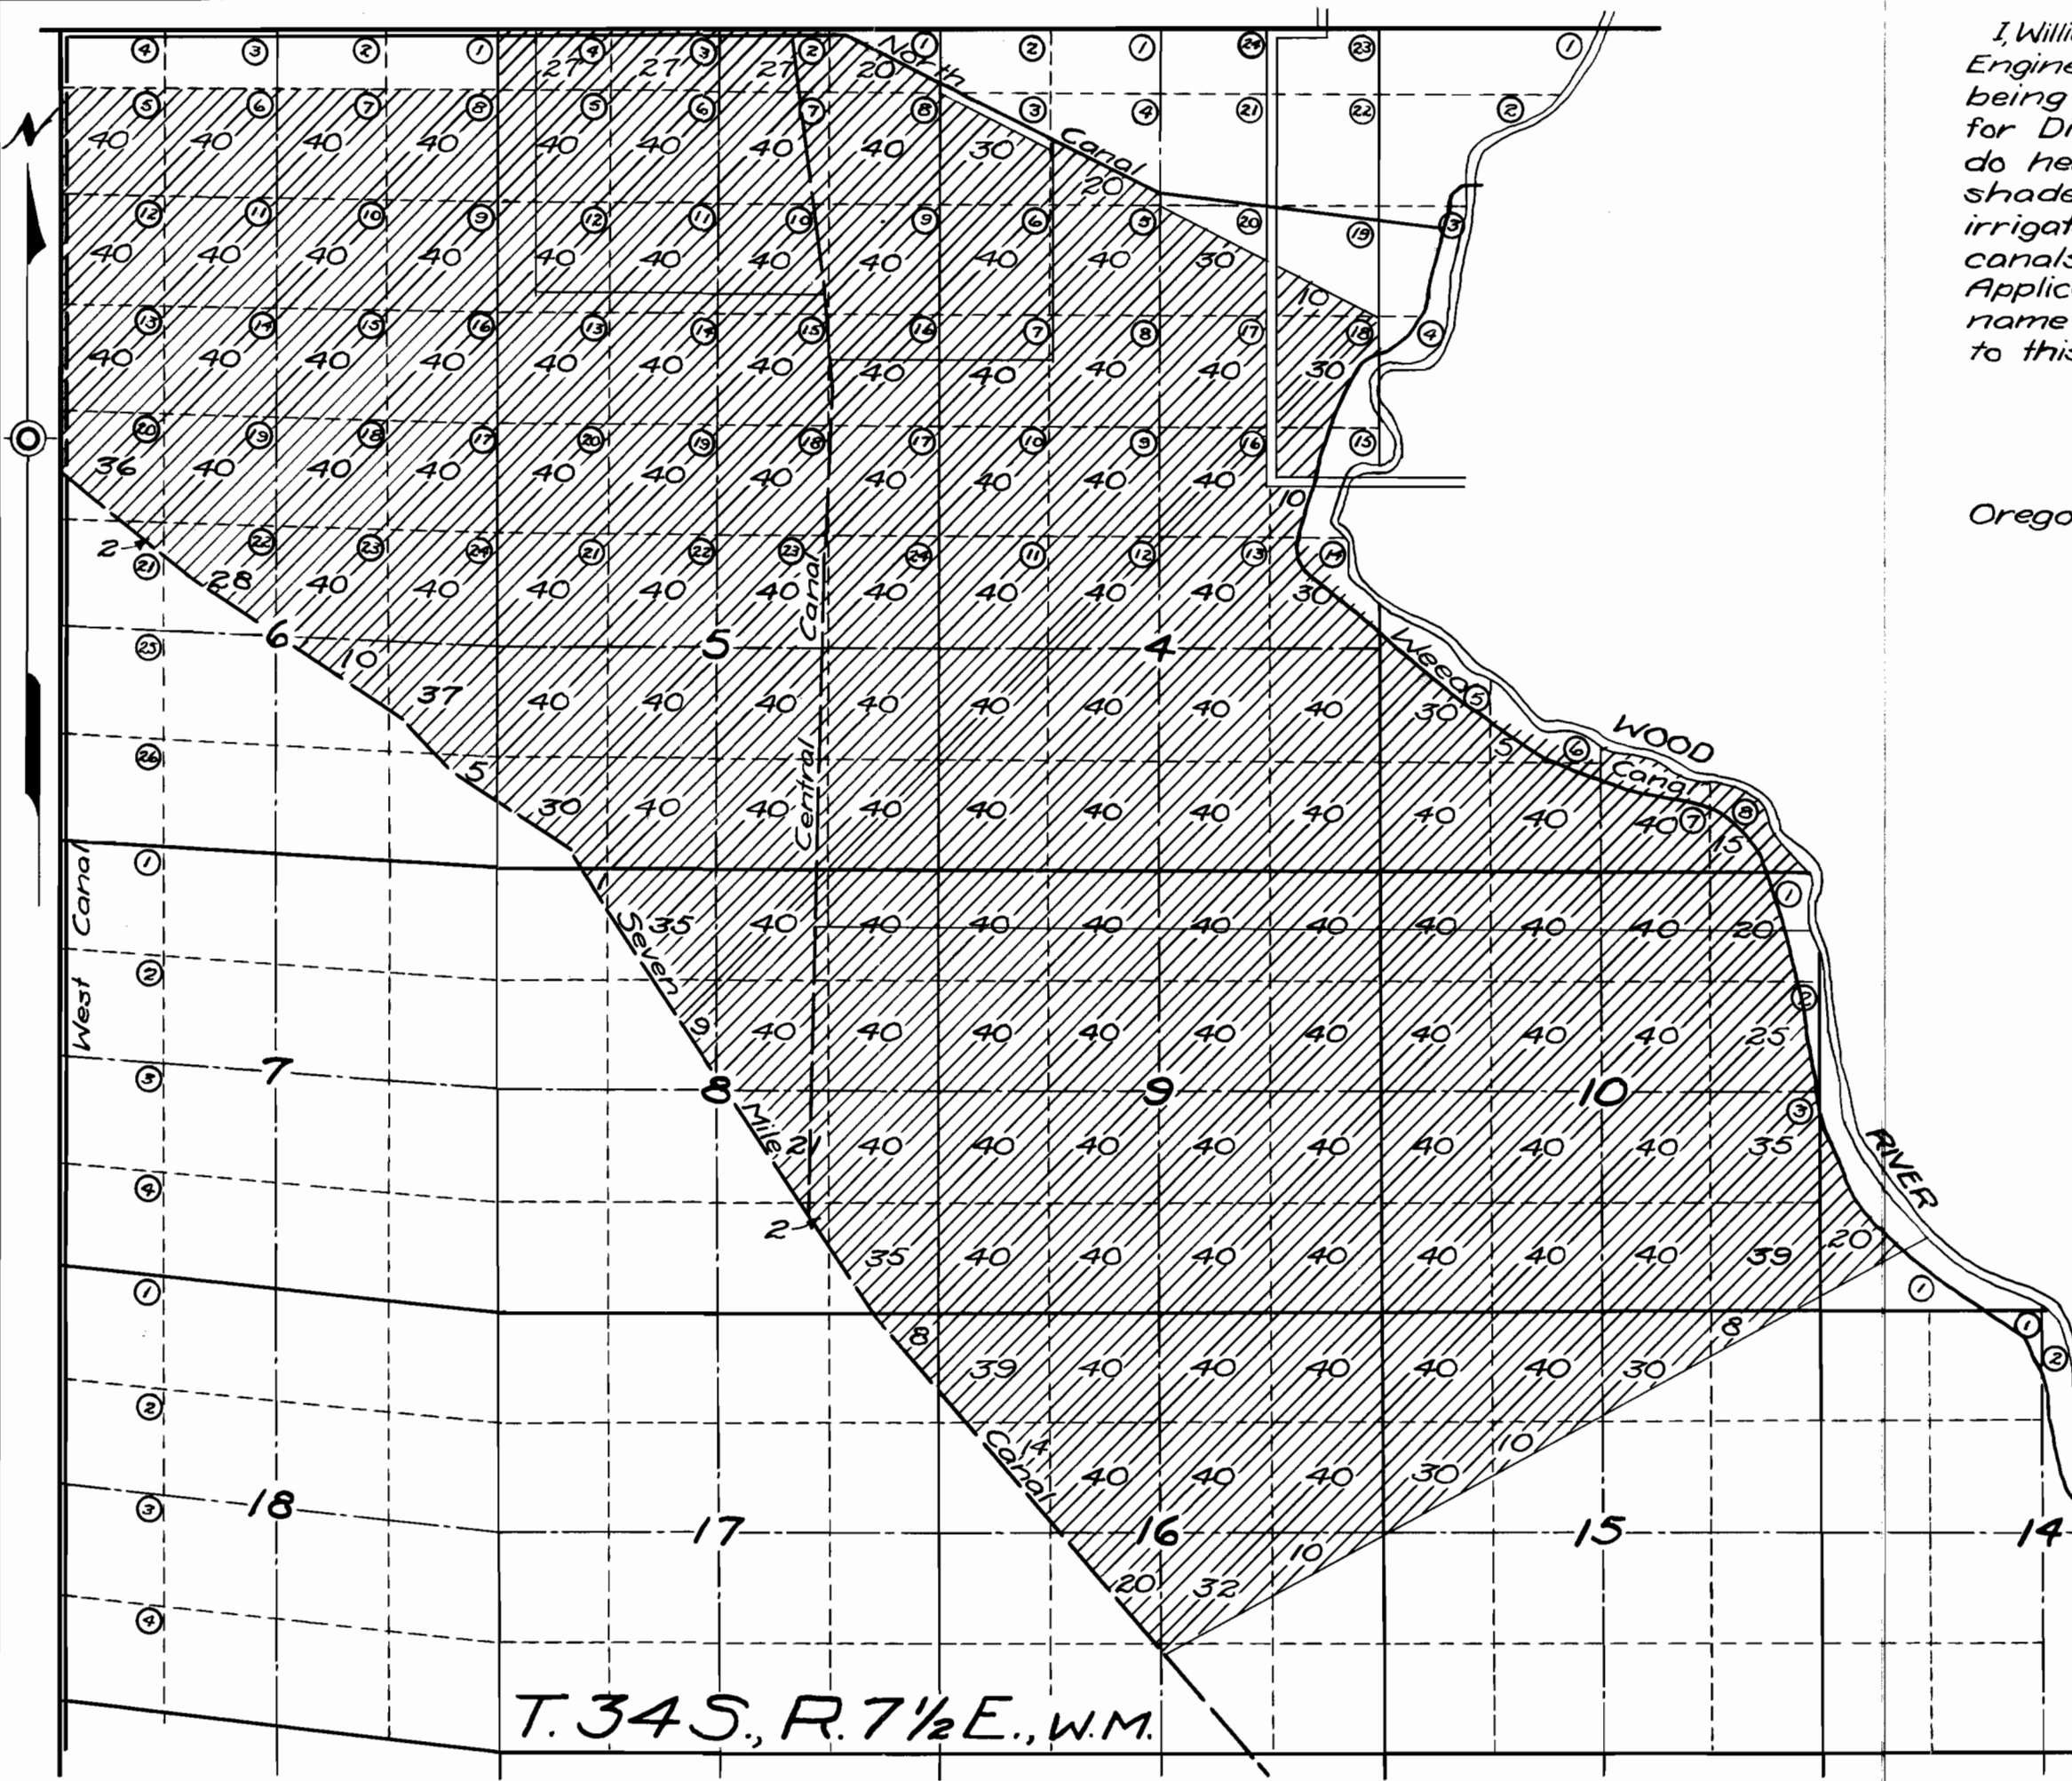

William L. Wales

MAP SHOWING
LANDS IRRIGATED IN
MEADOWS DRAINAGE
DISTRICT
KLAMATH COUNTY, OREGON
Scale: 1" = 2000'
Map Prepared By: William L. Wales
Civil & Hydraulic Eng'r.
Klamath Falls, Oregon.