T. 34 & 35 S. R. 7 1/2 E. W. M.

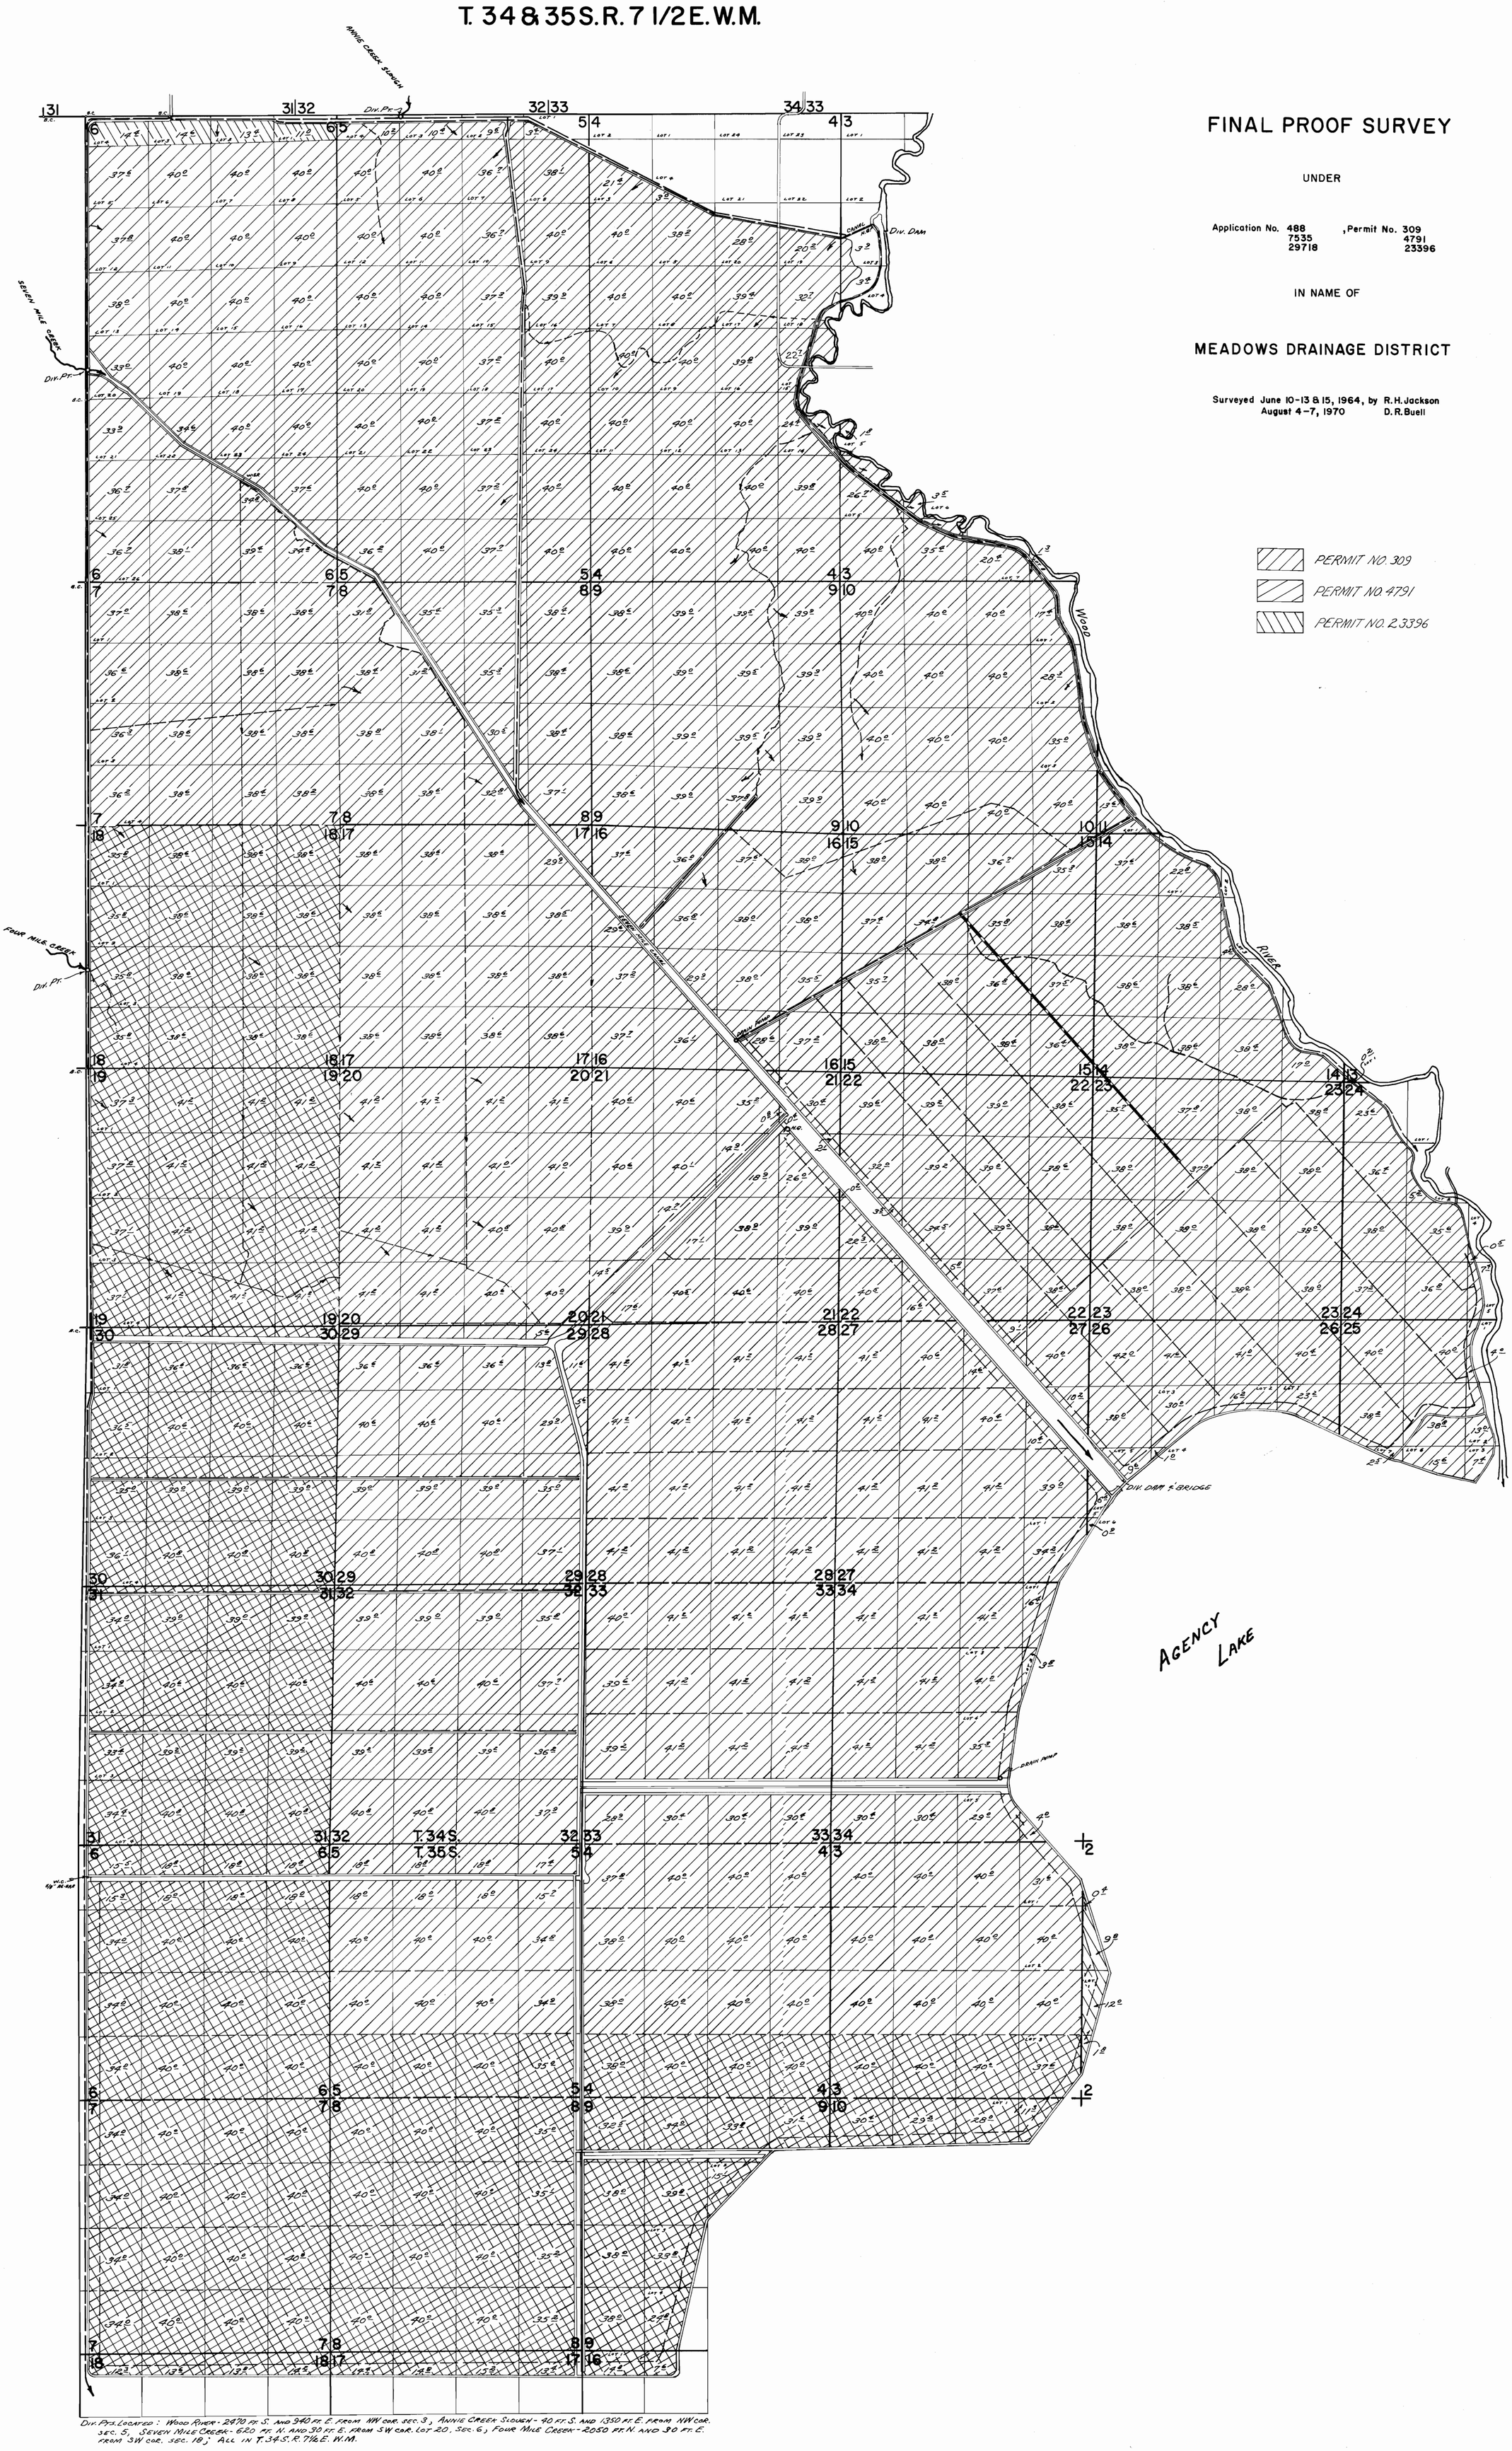

Div. Pts. Located: Wood River - 2470 ft. S. and 940 ft. E. from NW cor. sec. 3; Annie Creek Slough - 90 ft. S. and 1350 ft. E. from NW cor. sec. 5, Seven Mile Creek - 620 ft. N. and 30 ft. E. from SW cor. Lot 20, sec. 6; Four Mile Creek - 2050 ft. N. and 30 ft. E. from SW cor. sec. 18; all in T. 34 S. R. 7 1/2 E. W. M.

FINAL PROOF SURVEY

UNDER

Application No. 488, 7535, 29718 ; Permit No. 309, 4791, 23396

IN NAME OF

MEADOWS DRAINAGE DISTRICT

Surveyed June 10-13 & 15, 1964, by R. H. Jackson
August 4-7, 1970 D. R. Buell

PERMIT NO. 309

PERMIT NO. 4791

PERMIT NO. 23396