


T.10S. R.3W. W.M.

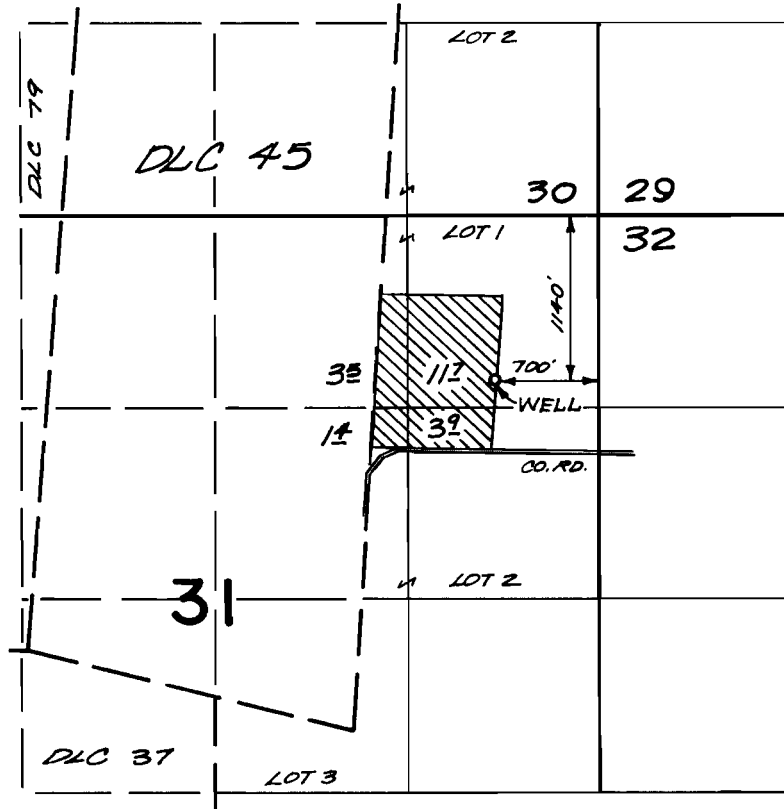

FINAL PROOF SURVEY UNDER

Application No. G5334 Permit No. G4993
IN NAME OF

ELMER L. NOFZIGER

Surveyed JULY 3 1974, by L.M. TOLL