


T.12S. R.5 & 6 W. W.M.

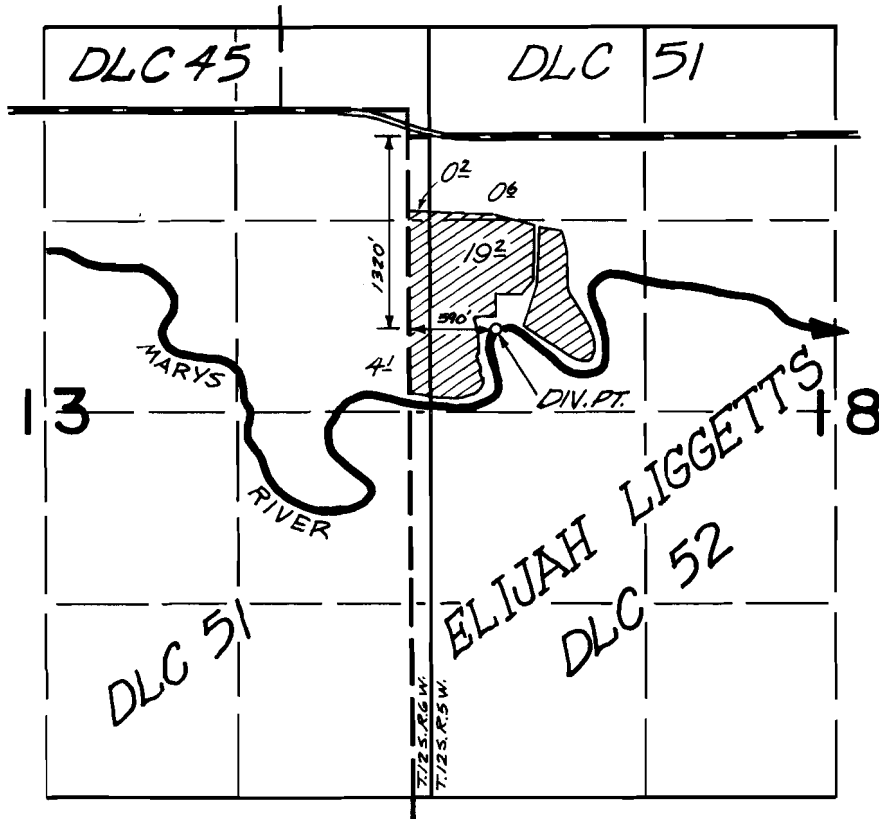

FINAL PROOF SURVEY
UNDER

Application No. 45526 Permit No. 33973
IN NAME OF

FAXON FARMS

Surveyed JULY 6 1974, by L.M. TOLL