


T.10S. R.3W. W.M.

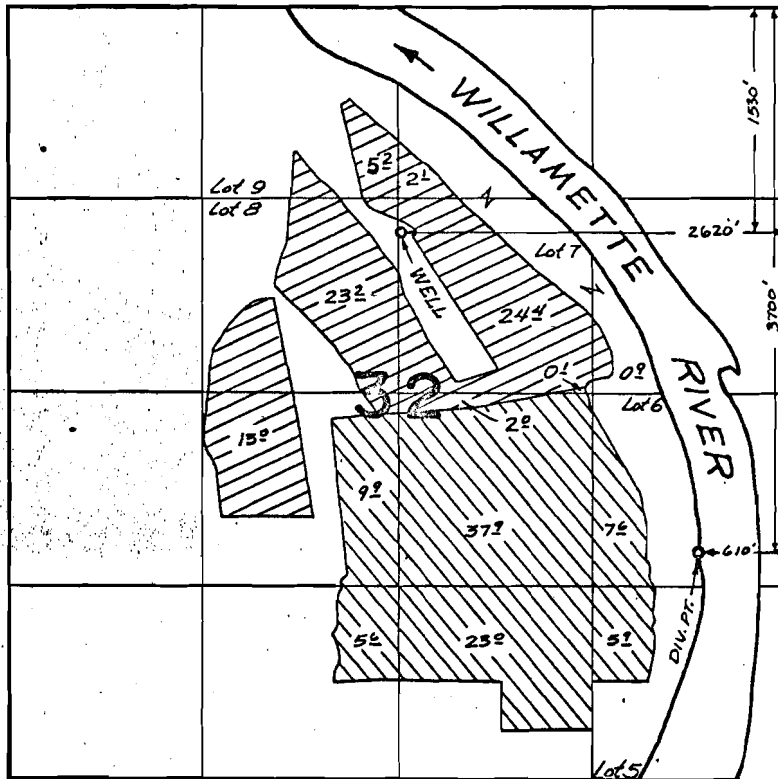

FINAL PROOF SURVEY
UNDER

Application No. 45615 Permit No. 34025
05960 G5029
IN NAME OF

MILTON L. COOLEY

Surveyed JULY 2 1974 by L.M. TOLL