


T.12S., R.6W., W.M.

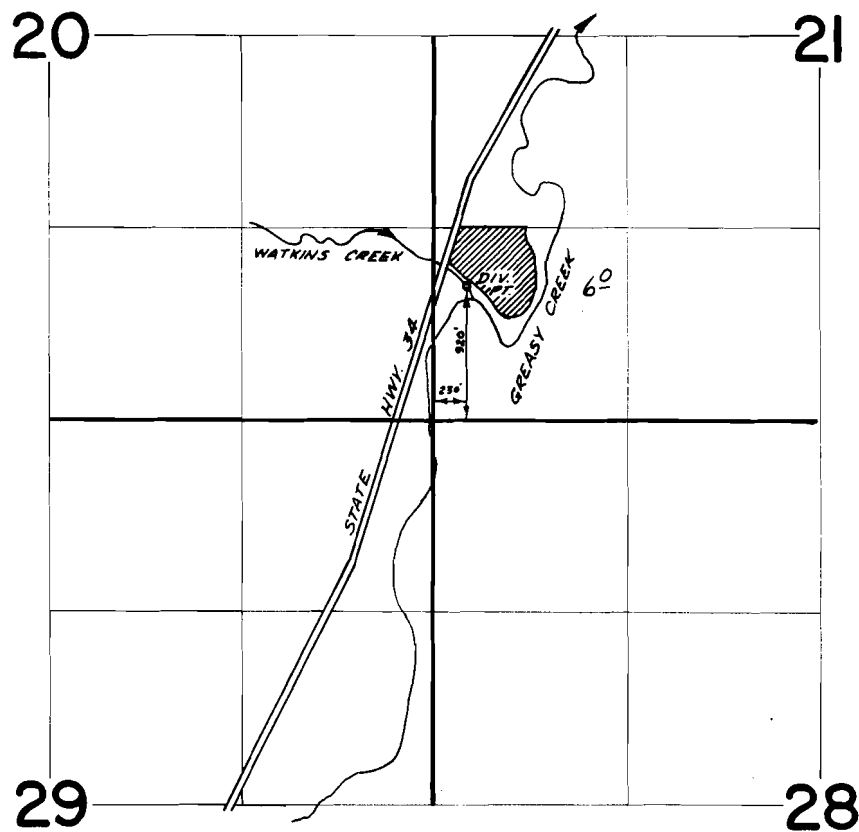

FINAL PROOF SURVEY
UNDER

Application No. 46286 Permit No. 34575
IN NAME OF

LAWRENCE P. AND BARBARA J. SELINSKI

Surveyed Sept. 24 1974, by D. Dorby