


T.12S., R.6W., W.M.

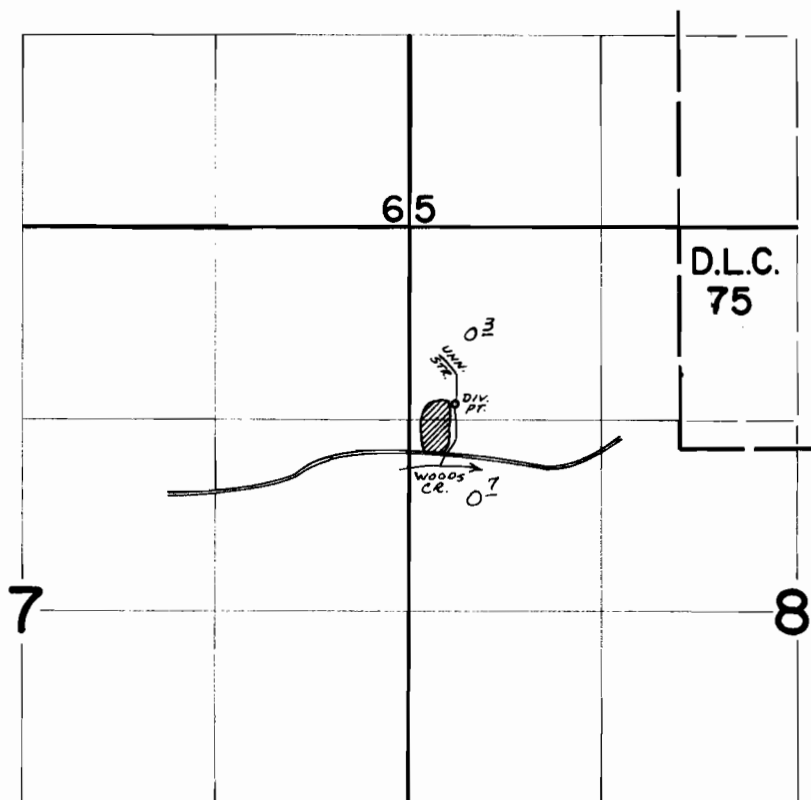

DIV. PT. LOCATED: 110' N & 320' E FROM SW COR. NW $\frac{1}{4}$ /NW $\frac{1}{4}$  SEC 8.

**FINAL PROOF SURVEY**  
UNDER

Application No. 47615 Permit No. 35221  
IN NAME OF

FRANK ERVIN

Surveyed Sept. 24 1974, by D. Dorby